

MICHIGAN STATE
U N I V E R S I T Y

**INFRASTRUCTURE PLANNING AND FACILITIES
PLANNING, DESIGN AND CONSTRUCTION**

January 13, 2026

TITLE OF PROJECT: Human Ecology – Replace Roofs and Complete Masonry Restoration

PROJECT ISSUE DATE: December 10, 2025

PROJECT NUMBER: CP24039

ADDENDUM NO: 01

GENERAL

This Addendum is issued prior to receipt of Proposals to amend the Contract Documents identified as Human Ecology – Replace Roofs and Complete Masonry Restoration, Bid Set (BD-0001).

Except as otherwise specifically mentioned, the general character of the work required by this Addendum shall be the same as originally specified, and all incidentals required in connection with the work hereinafter described shall be included even though not specifically mentioned. When an item is mentioned with additional specifications given, reference shall be made to the original specifications.

Documents(s) accompanying this Addendum include:

<u>ITEM NO.</u>	<u>DESCRIPTION</u>
1	Pre-Bid Walkthrough Sign-in Sheet, dated January 6, 2026
2	Building Envelope Study by RTA, dated August 6, 2021
3	Original Building Record Drawings, dated 1922
4	Specification Section 012100 – Allowances
5	Specification Section 012200 – Unit Prices
6	Specification Section 012300 – Alternates
7	Revised Bid Due Date: Tuesday, February 3, 2026 @ 3p.m.

CP24039 - Human Ecology Replace Roofs & Complete Masonry Restoration
 Prebid Walkthrough Sign-in (01/06/2026)

Name	Company	Title	Phone	Email
Carter Vandlen	Lolux Construction	Estimator	(517) 694-0117	Estimating@loluxconstruction.com
Vincenzo Vitale	Ram Construction	Project engineer	734-626-3310	Vvitale@ramservices.com
RICK ACKLEY	Bornor Rest.	ESTIMATOR	(517) 749-0625	RICK@Bornor.com
DAVIN MEAD	Bornor Rest	Estimator	517 4821925	dmead@bornor.com
Tom Ward	D.C. Byers	Estimator	734-7703691	tward@dcbyersdetroit.com
Dave McAllum	Bornor Restoration	Estimator	517 2021433	davem@bornor.com
Joe Westerbeck	ENG.	Engineer	630.441.4232	westerbeck@anglest.com
Sam Sucura	Royal Roofing	Estimator	586 246-5600	ssucura@Royal-Roofing.com
Rob Beard	Davenport	Estimator	517 927 1354	rbeard@davenportmasonry.com
Brandon Cusack	Cusack's Masonry	Estimator	989 981 6625	mail@CusacksMasonry.com
Matt Boileau	Pullman SST	"	734-318-3380	MBOILEAU@PULLMAN-Services.com
John Haberkom	Connally Crane	Estimator	734-660-3121	John@ConnallyCrane.com
Max Glover	CEI Michigan LLC	Estimator	248-613-6031	mglover@ceimichiganllc.com
BRADY SACK	MHM Enterprises	PM	616-648-2600	info@mhmedventures.com
~ n. ~	MHM	Estimator	269-751-5522	info@mhmenterprises.com

Bill BREMER | MIHM ENTERPRISES | ESTIMATOR 231-590-6906 | brem820@gmail.com
Michael Cygan | Colasanti | VP/Estimator 248-520-1613 | mcygan@colasantigroup.com

Dan Walcutt Nielsen Const. 517-896-0735 dwalcutt@nielsenconstructioninc.com

STEPHEN HERWOLUS NATIONAL RESTORATION INC. ESTIMATOR (248) 885-2045 ~~STEPHEN~~ JACOB F C NATIONAL
RESTORATION.NET



ROOFING TECHNOLOGY ASSOCIATES, LTD.

38031 SCHOOLCRAFT
LIVONIA, MICHIGAN 48150-1065
(734) 591-4444 • FAX (734) 591-1660 • E-MAIL: rta@rtaltd.com
Web site www.rtaltd.com

August 6, 2021
Project No. 21-054

Planning Design Construction
Infrastructure Planning and Facilities
Michigan State University
East Lansing, MI 48824

RE: BUILDING ENVELOPE STUDY
Human Ecology Building
552 W Circle Dr.
East Lansing, MI 48823

In accordance with our agreement, a building envelope study was performed on the above-referenced building by representatives of Roofing Technology Associates, Ltd. (RTA) on July 19th, 2021. The purpose of the study was to analyze and evaluate the existing conditions in order to develop conclusions, recommendations and budget estimates for corrective action.

Photographs that were taken during the study and are attached to this report to add clarity to our findings. They are grouped as follows: Asbestos Tile Roofs, Low-slope Roofs, and Masonry. A Roof Area ID Plan, which was provided by you, is also attached to the end of this report.

GENERAL CONDITIONS

The project building was constructed around 1922. The roofs on Areas 1 and 5 are reported to have been installed around 1924. The roofs on Areas 2, 4, 7, and 11 are reported to have been installed around 1966. Area 3 was installed in 1980. Areas 6, 8, 9 and 10 were replaced in 2018 (See *Figure 1: Roof Plan* below).

Areas 1, 5 and 11 are steep sloped roofs covered with asbestos tiles. Areas 2, 4 and 7 are covered with coal-tar pitch built-up roof systems. Areas 6, 8, 9 and 10 are covered with modified bitumen roof systems.

EXISTING CONDITIONS – Asbestos Tile Roofing (Areas 1, 5 and 11)

The roofs of Areas 1, 5 and 11 are covered with asbestos tile and copper roofing. The asbestos tile roofing is present on the main slopes of the building and on the walls of the dormers. The asbestos tile roofs drain into copper gutters and downspouts. The copper roofs are located on top of the dormers. The copper roofs drain over their eave edges onto the asbestos tile roofs.

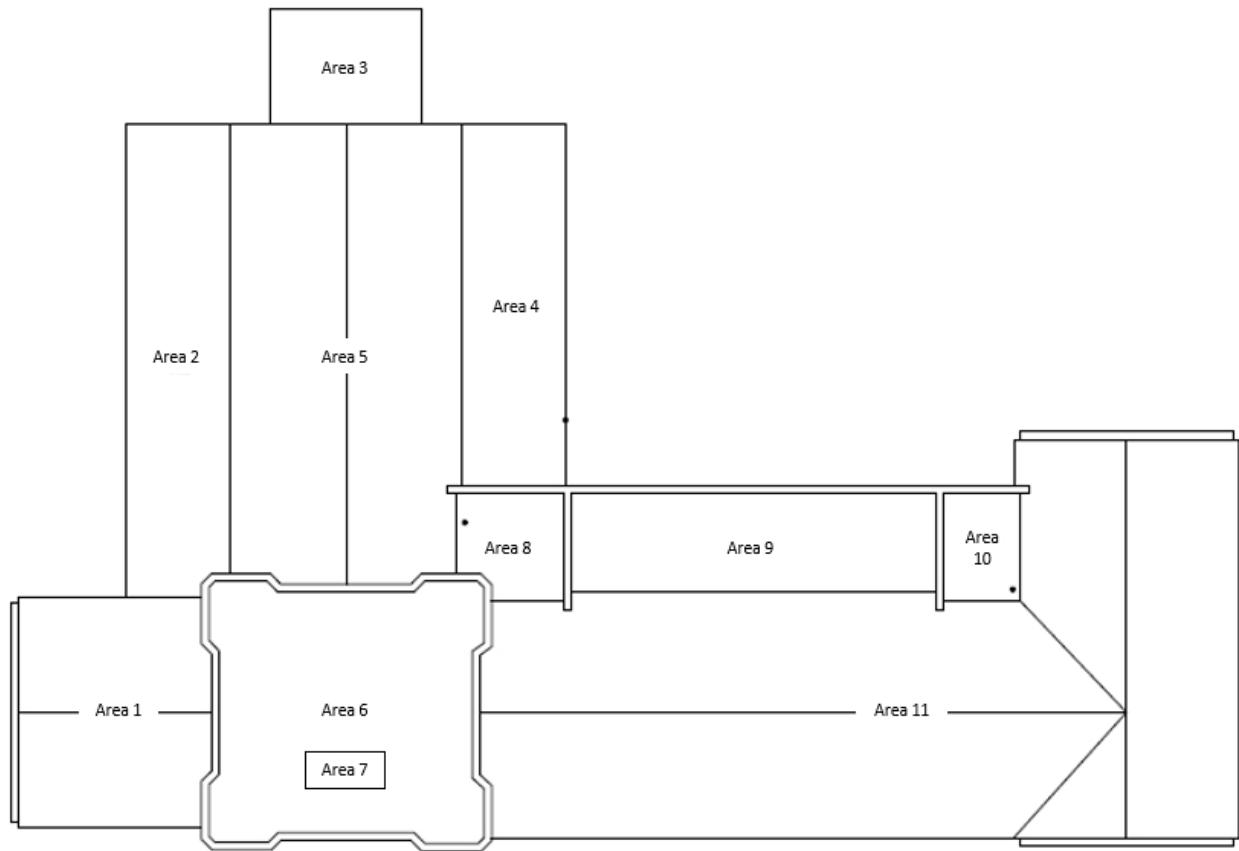


Figure 1: Roof Plan

The asbestos tile roofs cannot be walked upon safely or without causing further damage and were thus observed from a man-lift, which was provided and operated by MSU staff. The existing asbestos tiles on the roofs are in poor condition overall. The copper roofs on the towers and turrets appeared weathered with stains and pitting. The following deficient conditions were observed during the survey of the roofs:

Area 1:

1. Moss is growing between the asbestos tiles (Photo Report: Asbestos Tile Roofs, Photos 1, 2, 4 and 5).
2. The asbestos tiles are stained and weathered with age (Photos 1, 2, 4, 5, and 9-12).
3. The slope on the roof of the dormer on the north facing is not steep enough for asbestos tile shingles to properly shed water (Photo 6). The wood trim around the louvers is weathered and beginning to warp/split (Photo 3).



4. There are numerous broken asbestos tiles on the south facing, as they have become brittle with age (Photos 7, 11, and 12).
5. The copper step flashing is bent away from the wall (Photos 7 and 12).

Area 5:

1. Moss is growing between the asbestos tiles (Photo 20).
2. The asbestos tiles are stained and weathered with age (Photos 14 - 19, and 21).
3. There are numerous broken asbestos tiles on the both the east and west facings, as they have become brittle with age (Photos 14 - 19, and 21).
4. The copper gutter is functional but has begun to pull away from the wall in the corner (Photo 23).

Area 11:

1. The asbestos tiles are stained and weathered with age (Photos 27, 30, 31, and 34).
2. There are numerous broken asbestos tiles on the all facings, as they have become brittle with age (Photos 27, 30, 31, 34, 35, and 36).
3. Moss is growing between the asbestos tiles on the north facing (Photos 40 and 41).
4. There are a few loose/missing asbestos tiles (Photos 39 and 42).
5. The copper roofs and framing on the dormers are stained and pitting (Photos 28, 29, 33, and 34).

EXISTING CONDITIONS – Low-slope Roofs (Areas 2, 3, 4, and 6 through 10)

The roofs of Areas 2, 3, 4 and 7 are covered with coal-tar pitch built-up roofing. These roofs are well past their service life in age. Areas 6, 8, 9 and 10 are covered with modified bitumen roofing. These roofs are relatively new and should remain serviceable for another 20 years or more. The following deficient conditions were observed during the survey of the roofs:

Area 2:

1. The roof surface is covered with widespread vegetation. Due to its low slope and proximity to an overhanging tree, debris and moss have accumulated on the membrane (Photo Report: Low-slope Roofs, Photos 2, 3 and 4).
2. The drain strainer is broken (Photo 6).
3. The surface of the roof and the base flashings are showing signs of age, surface wear (Photo 5).



Area 3:

1. Moss has accumulated on the membrane against the south wall (Photo 7).
2. The surface of the roof and the base flashings are showing signs of age, surface wear (Photos 7 and 8).
3. The base flashings have deteriorated (Photo 9).

Area 4:

1. The surface of the roof and the base flashings are showing signs of age, surface wear (Photos 12 - 16).
2. Debris/vegetation accumulating on the roof (Photos 12 - 15).

Area 7:

1. The surface of the roof and the base flashings are deteriorated (Photos 21-24).

EXISTING CONDITIONS – Masonry

We consulted with Bornor Restoration for the masonry portion of the building envelope study, in order to leverage their expertise in the repair and preservation of masonry buildings. The following deficient conditions were observed during the survey of the subject building's exterior masonry components:

Caulking:

1. Defective caulking around the perimeter windows (Photo Report: Masonry, Photos 1 and 2).
2. Missing caulking (Photo 3)
3. Head joints in need of caulking (Photos 4 through 7).

Tuckpointing:

1. Defective mortar joints: mortar is loose, eroded or powdered, broken, hollow, unsound or soft (Photos 8 – 14).

Stone Patching

1. Broken or spalled pieces of stone (Photos 15 – 16).



ANALYSIS AND CONCLUSIONS

Based upon the findings of our observations, it is our opinion that the asbestos tile roofs (Areas 1, 5 and 11) have surpassed their serviceable life and are in need of replacement. Efforts to sustain the asbestos tiles would not be cost effective and would not measurably extend the life of the roof. Although the copper gutters and downspouts are functional, they are showing signs of age. It is recommended they be replaced along with the copper caps on the dormers, in order to provide a long-lasting roof compatible with the historic aesthetic of the original building and its surroundings. The dormer on Area 1 should receive a new copper roof rather than shingle tiles due to its low slope.

The low slope roofs which are covered with coal-tar pitch built-up roofing (Areas 2, 3, 4 and 7) have also surpassed their serviceable life and are in need of replacement.

The low slope roofs which are covered with modified bitumen roofing (areas 6, 8, 9 and 10) are in good condition and require no remedial action.

The exterior masonry requires caulking, tuckpointing and stone patching.

RECOMMENDATIONS

The asbestos contained within the roof tiles on Areas 1, 5 and 11 may be regulated at the state and/or federal levels regarding removal and disposal. Since the asbestos is contained in a cementitious binder versus an asphalt binder, the training required by removal and monitoring personnel is higher than most roofing companies have achieved. Most likely an asbestos abatement company will need to remove, handle and dispose of the asbestos shingles and advise MSU on proper procedures and regulations.

We recommend that the asbestos tiles, once removed, should be replaced with either slate or flat terra cotta clay roof tiles. The replacement cost budget, including the copper dormers, gutters and downspouts, is approximately \$45 to \$50 per square foot. For the steep roofs, currently covered with asbestos tiles, the total cost of the roof replacement (not including the cost of the asbestos abatement company) should be budgeted between \$450,000 to \$500,000

The low-slope coal-tar pitch built-up roofs should be replaced with a 3-ply modified bitumen roof consistent with MSU roofing standards. We estimate these roofs will cost approximately \$25 to \$30 per square foot. The total cost of the low slope roofs should be budgeted between \$75,000 to \$90,000.

With regards to the masonry repairs, the following remedial actions are recommended.

1. Caulking around perimeter of windows, louvers, doors, and at all previously caulked head joints and coping joints, belt courses and water tables.
 - a. Cut out all existing materials around the perimeter of windows, louvers and doors. Clean substrate to be recaulked by scraping, wire brushing, or grinding with an abrasive blade if needed. After substrate has been cleaned, install closed-cell backer-rod as needed, and recaulk window, louver and door perimeters 100% using Dow Corning® 791-756 sealants, installed as per the manufacturer's specifications.



2. Tuckpointing - Repoint all defective mortar joints on the exterior masonry.
 - a. Defective joints are those in which the mortar is loose, eroded or powdered, broken, hollow, unsound or soft. Joints with fine hairline and fine shrinkage cracks that are otherwise sound, full and solid will not be considered as defective. Defective joints shall be cut to a depth of $\frac{3}{4}$ " or more using a machine grinder, pneumatic tools or hammer and chisel, and in such a manner so as to not damage the surface of the masonry. After mortar joints have been properly cut out, they shall be cleaned and washed out with water under sufficient pressure to remove all foreign matter, leaving the surfaces damp for new mortar. The prepared joints shall be firmly and neatly filled flush with non-shrinking mortar and tooled to match the existing joints. Color of new mortar shall match the existing mortar as near as possible. Precautions shall be taken against dropping or smearing pointing materials, leaving no pointing materials beyond the lines of the joints. After mortar has properly cured, face bricks shall be cleaned using water and Sure Klean 600 detergent or equal, brushing and scraping as necessary to remove all mortar from face bricks. Walls shall be thoroughly washed with clean water to remove all acid.

3. Stone Patching

- a. Remove broken or spalled pieces of stone. Saw cut around perimeter of area to be patched to the depth of $\frac{1}{2}$ " and patch back using Mimic Stone Patch or Jahn Patching Materials.

A recommended budget cost for the masonry remediation outlined above is \$275,000.

Thank you for the opportunity to serve you on this project. Please contact my office with any questions you may have regarding our findings.

Sincerely,

ROOFING TECHNOLOGY ASSOCIATES, LTD.

A handwritten signature in black ink, appearing to read 'James J. Watson'.

James J. Watson, RRC
Project Manager


Attachments



APPENDIX

Roof Area Plan	Sheet 8
Photo Report – Asbestos Tile Roofs (Photos 1 – 42)	7 pages
Photo Report – Low-Slope Roofs (Photos 1 – 30)	5 pages
Photo Report – Masonry (Photos 1 – 16)	4 pages

ROOF PLAN

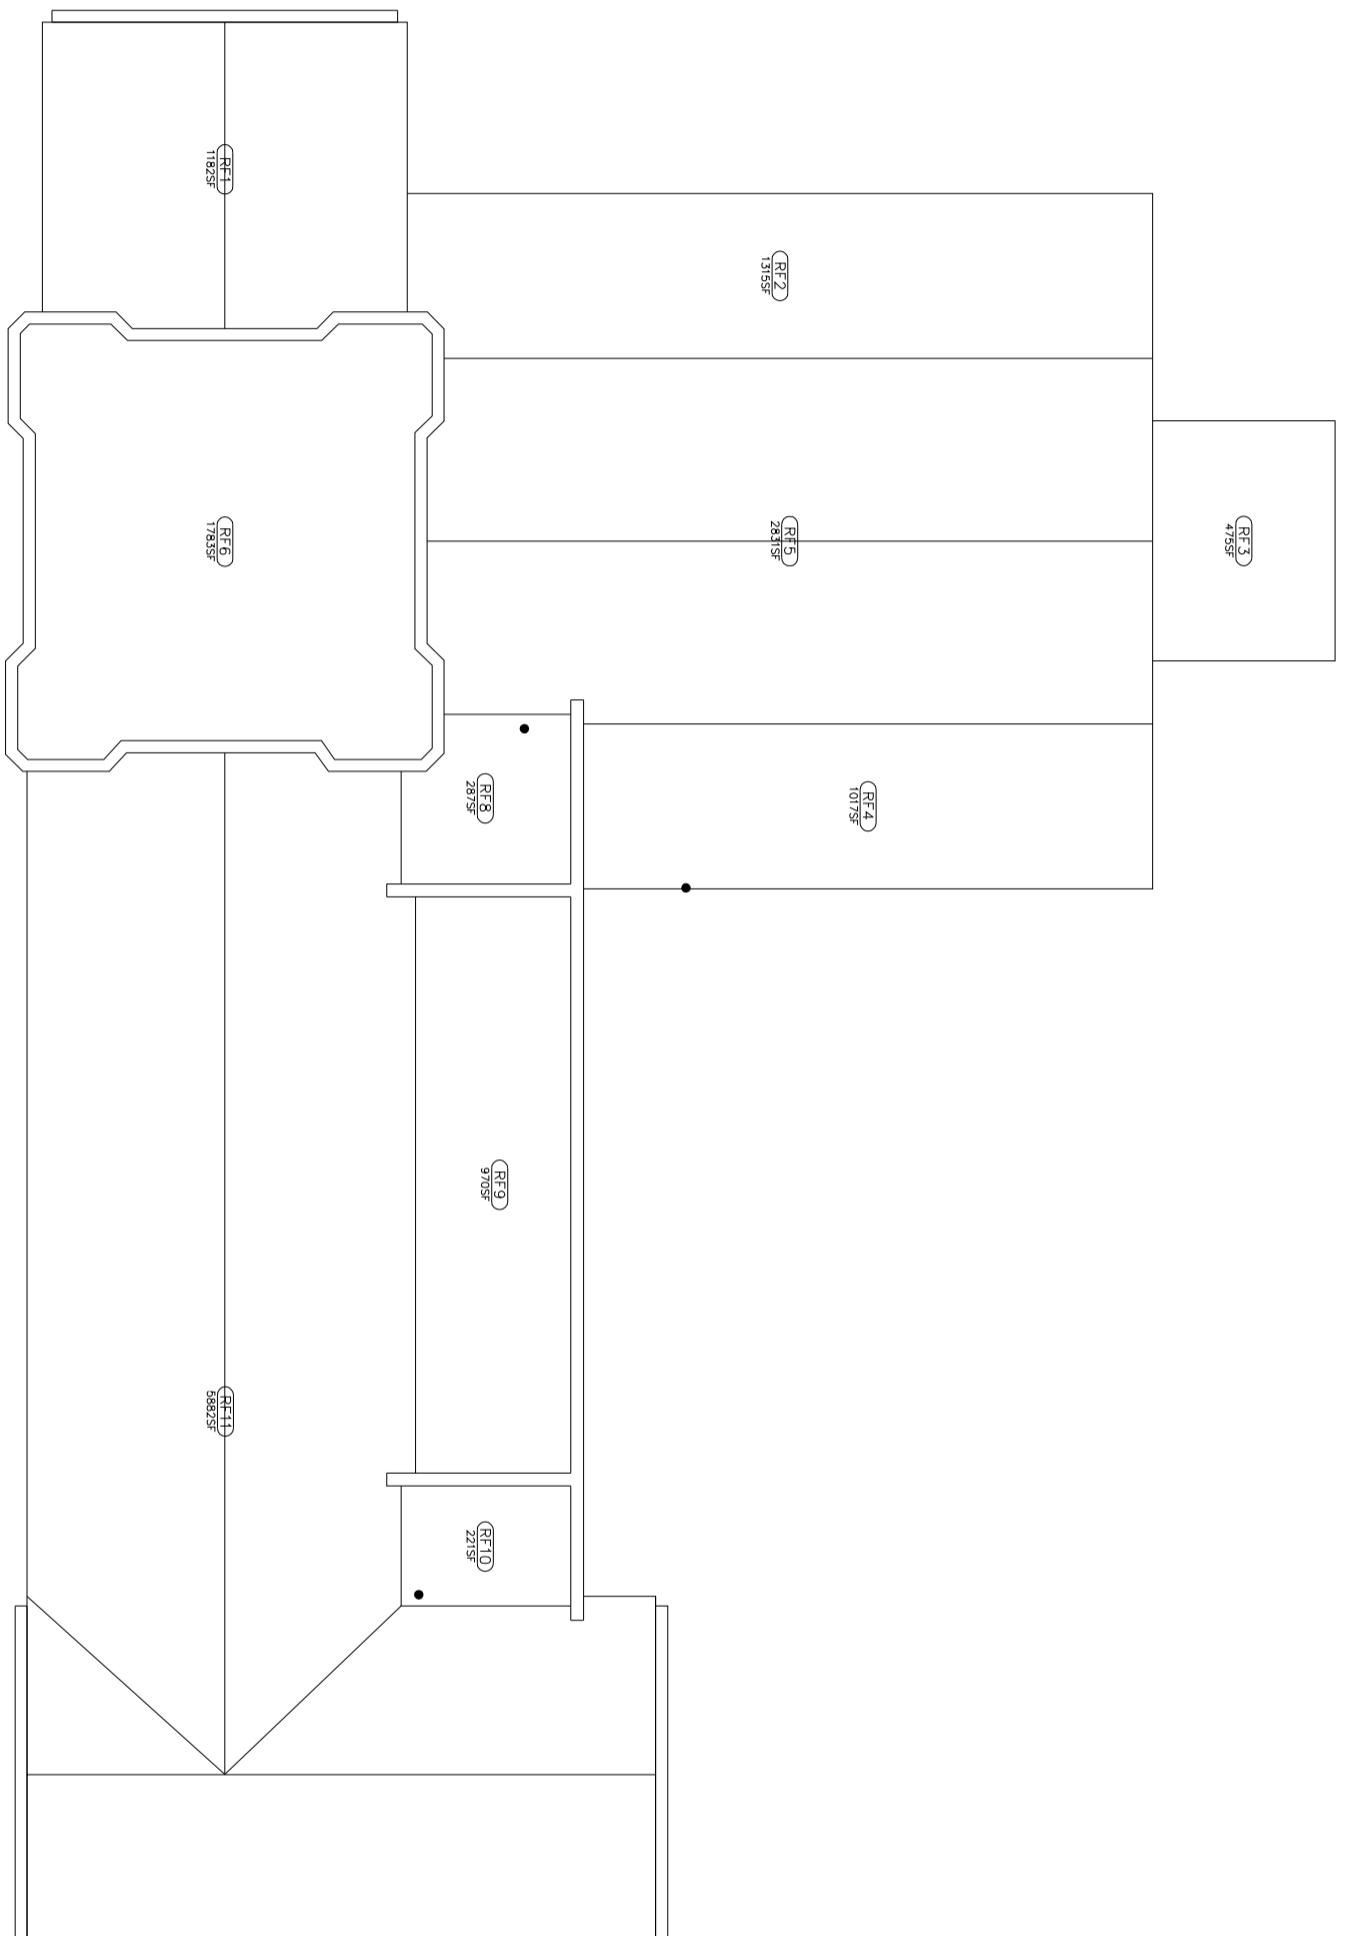


O_0005_R_BASE.DWG

HUMAN ECOLOGY

ROOF PLAN

MICHIGAN STATE
UNIVERSITY
Infrastructure
Planning and Facilities

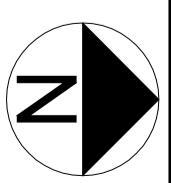

APPROVED BY
DATE 04-16-97
SCALE 1" = 20'

LAST REVISED ON 05-22-06
LAST REVISED BY JJC

BUILDING NO.

5

8

OF 8

Photo Report

ASBESTOS TILE ROOFS

MSU HUMAN ECOLOGY BUILDING
BUILDING ENVELOPE STUDY

August 6, 2021



Photo 1: Area 1 - stained/weathered/moss growth between asbestos tiles



Photo 2: Area 1 - stained/weathered/moss growth between asbestos tiles



Photo 3: Area 1 - weathered lumber around louvers - missing asbestos tiles



Photo 4: Area 1 - stained/weathered/moss growth between asbestos tiles



Photo 5: Area 1 - stained/weathered/moss growth between asbestos tiles



Photo 6: Area 1 - slope of dormer roof is inadequate to provide required drainage of a tile



Photo 7: Area 1 - broken asbestos tiles - bent step flashing



Photo 8: Area 1 - stained/weathered/broken asbestos tiles

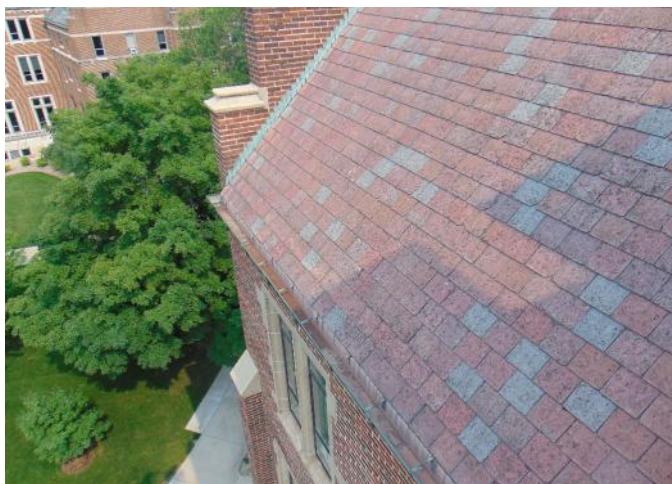


Photo 9: Area 1 - stained/weathered asbestos tiles



Photo 10: Area 1 - stained/weathered asbestos tiles



Photo 11: Area 1 - stained/weathered/broken asbestos tiles



Photo 12: Area 1 - stained/weathered/broken asbestos tiles - bent step flashing



Photo 13: Area 5 - east facing



Photo 14: Area 5 - stained/weathered/broken asbestos tiles



Photo 15: Area 5 - stained/weathered/broken asbestos tiles



Photo 16: Area 5 - stained/weathered/broken asbestos tiles



Photo 17: Area 5 - west facing - stained/weathered/broken asbestos tiles



Photo 18: Area 5 -stained/weathered/broken asbestos tiles



Photo 19: Area 5 - stained/weathered/broken asbestos tiles



Photo 20: Area 5 - stained/weathered/moss growing between asbestos tiles



Photo 21: Area 5 - stained/weathered/broken asbestos tiles



Photo 22: Area 5 - gutter and downspout



Photo 23: Area 5 - gutter corner/transition



Photo 24: Area 5 - gutter and downspouts



Photo 25: Area 11 - South facing overview



Photo 26: Area 11 - South facing overview



Photo 27: Area 11 - stained/weathered/broken asbestos tiles



Photo 28: Area 11 - stained/pitting copper on dormer cap roofs



Photo 29: Area 11 - stained/pitting copper on dormer cap roofs



Photo 30: Area 11 - stained/weathered/broken asbestos tiles



Photo 31: Area 11 - stained/weathered/broken asbestos tiles



Photo 32: Area 11 - west facing - overview



Photo 33: Area 11 - stained/pitted copper trim at dormer windows



Photo 34: Area 11 - stained/weathered/broken asbestos tiles - stained/pitted copper



Photo 35: Area 11 - loose/broken asbestos tiles



Photo 36: Area 11 - stained/weathered/broken asbestos tiles - bent step flashing



Photo 37: Area 11 - east and north facing overview



Photo 38: Area 11 - east facing overview



Photo 39: Area 11 - loose/missing asbestos tiles



Photo 40: Area 11 - north facing - moss growing between asbestos tiles



Photo 41: Area 11 - moss growing between asbestos tiles



Photo 42: Area 11 - north facing - loose tiles on dormer wall

Photo Report

LOW-SLOPE ROOFS

MSU HUMAN ECOLOGY BUILDING
BUILDING ENVELOPE STUDY

August 6, 2021



Photo 1: Area 2 - overview



Photo 2: Area 2 - widespread vegetation



Photo 3: Area 2 - debris/vegetation accumulation in corner



Photo 4: Area 2 - vegetation/surface wear



Photo 5: Area 2 -base flashing surface wear



Photo 6: Area 2 -broken drain strainer



Photo 7: Area 3 - moss/surface wear



Photo 8: Area 3 - deteriorated base flashing



Photo 9: Area 3 - deteriorated base flashing



Photo 10: Area 4 - overview



Photo 11: Area 4 - overview



Photo 12 Area 4 -debris/vegetation - base flashing surface wear



Photo 13: Area 4 - debris/vegetation - base flashing surface wear



Photo 14: Area 4 - debris/vegetation - base flashing surface wear



Photo 15: Area 4 - debris/vegetation - base flashing surface wear



Photo 16: Area 4 - surface wear



Photo 17: Area 6 - overview



Photo 18: Area 6 - overview



Photo 19: Area 6 - overview



Photo 20: Area 7 - overview

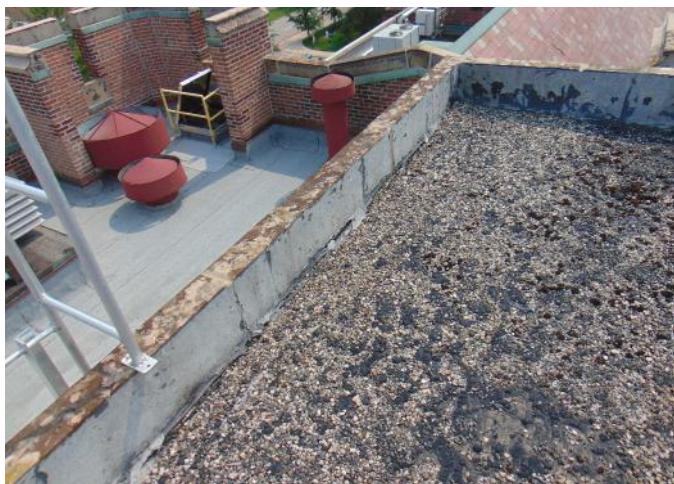


Photo 21: Area 7 - deteriorated surface and base flashing



Photo 22: Area 7 - deteriorated surface and base flashing



Photo 23: Area 7 - deteriorated surface and base flashing



Photo 24: Area 7 - deteriorated surface and base flashing



Photo 25: Area 8 - overview



Photo 26: Area 8 - membrane in good condition



Photo 27: Area 9 - overview



Photo 28: Area 9 - overview



Photo 30: Area 10 - overview

Photo Report

MASONRY

MSU HUMAN ECOLOGY BUILDING
BUILDING ENVELOPE STUDY

August 6, 2021



Photo 1: Typical defective caulking around the perimeter of windows



Photo 2: Typical defective caulking around the perimeter of windows



Photo 3: Missing caulking around louver



Photo 4: Typical head joint to be caulked



Photo 5: Typical head joint



Photo 6: Typical deteriorated mortar joint



Photo 7: Typical head joint



Photo 8: Typical tuckpointing



Photo 9: Typical eroded mortar joints



Photo 10: Typical head joint

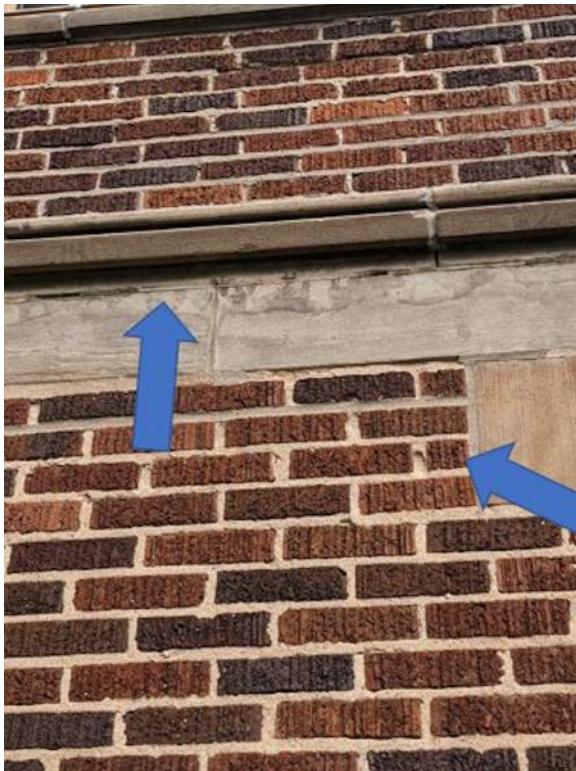


Photo 11: Typical eroded mortar joints



Photo 12: Typical eroded mortar joints



Photo 13: Typical eroded mortar joints

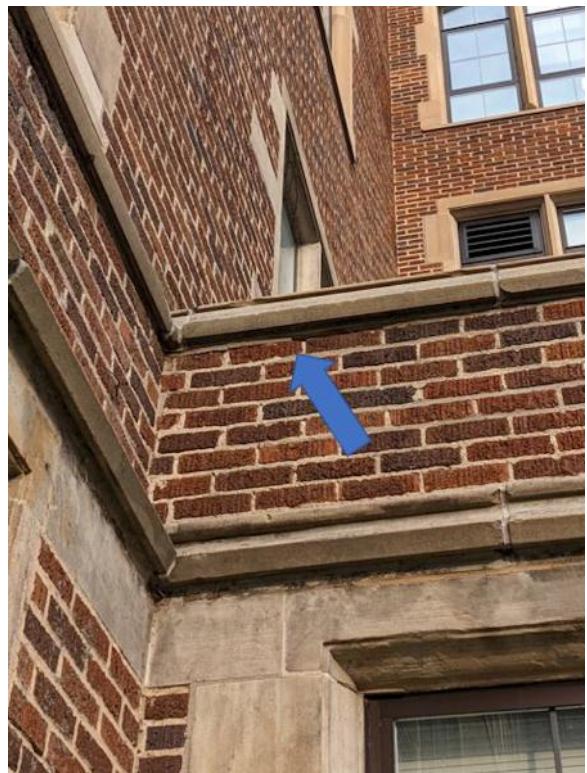



Photo 14: Typical eroded mortar joints



Photo 15: Typical stone patching



Photo 16: Typical stone patching

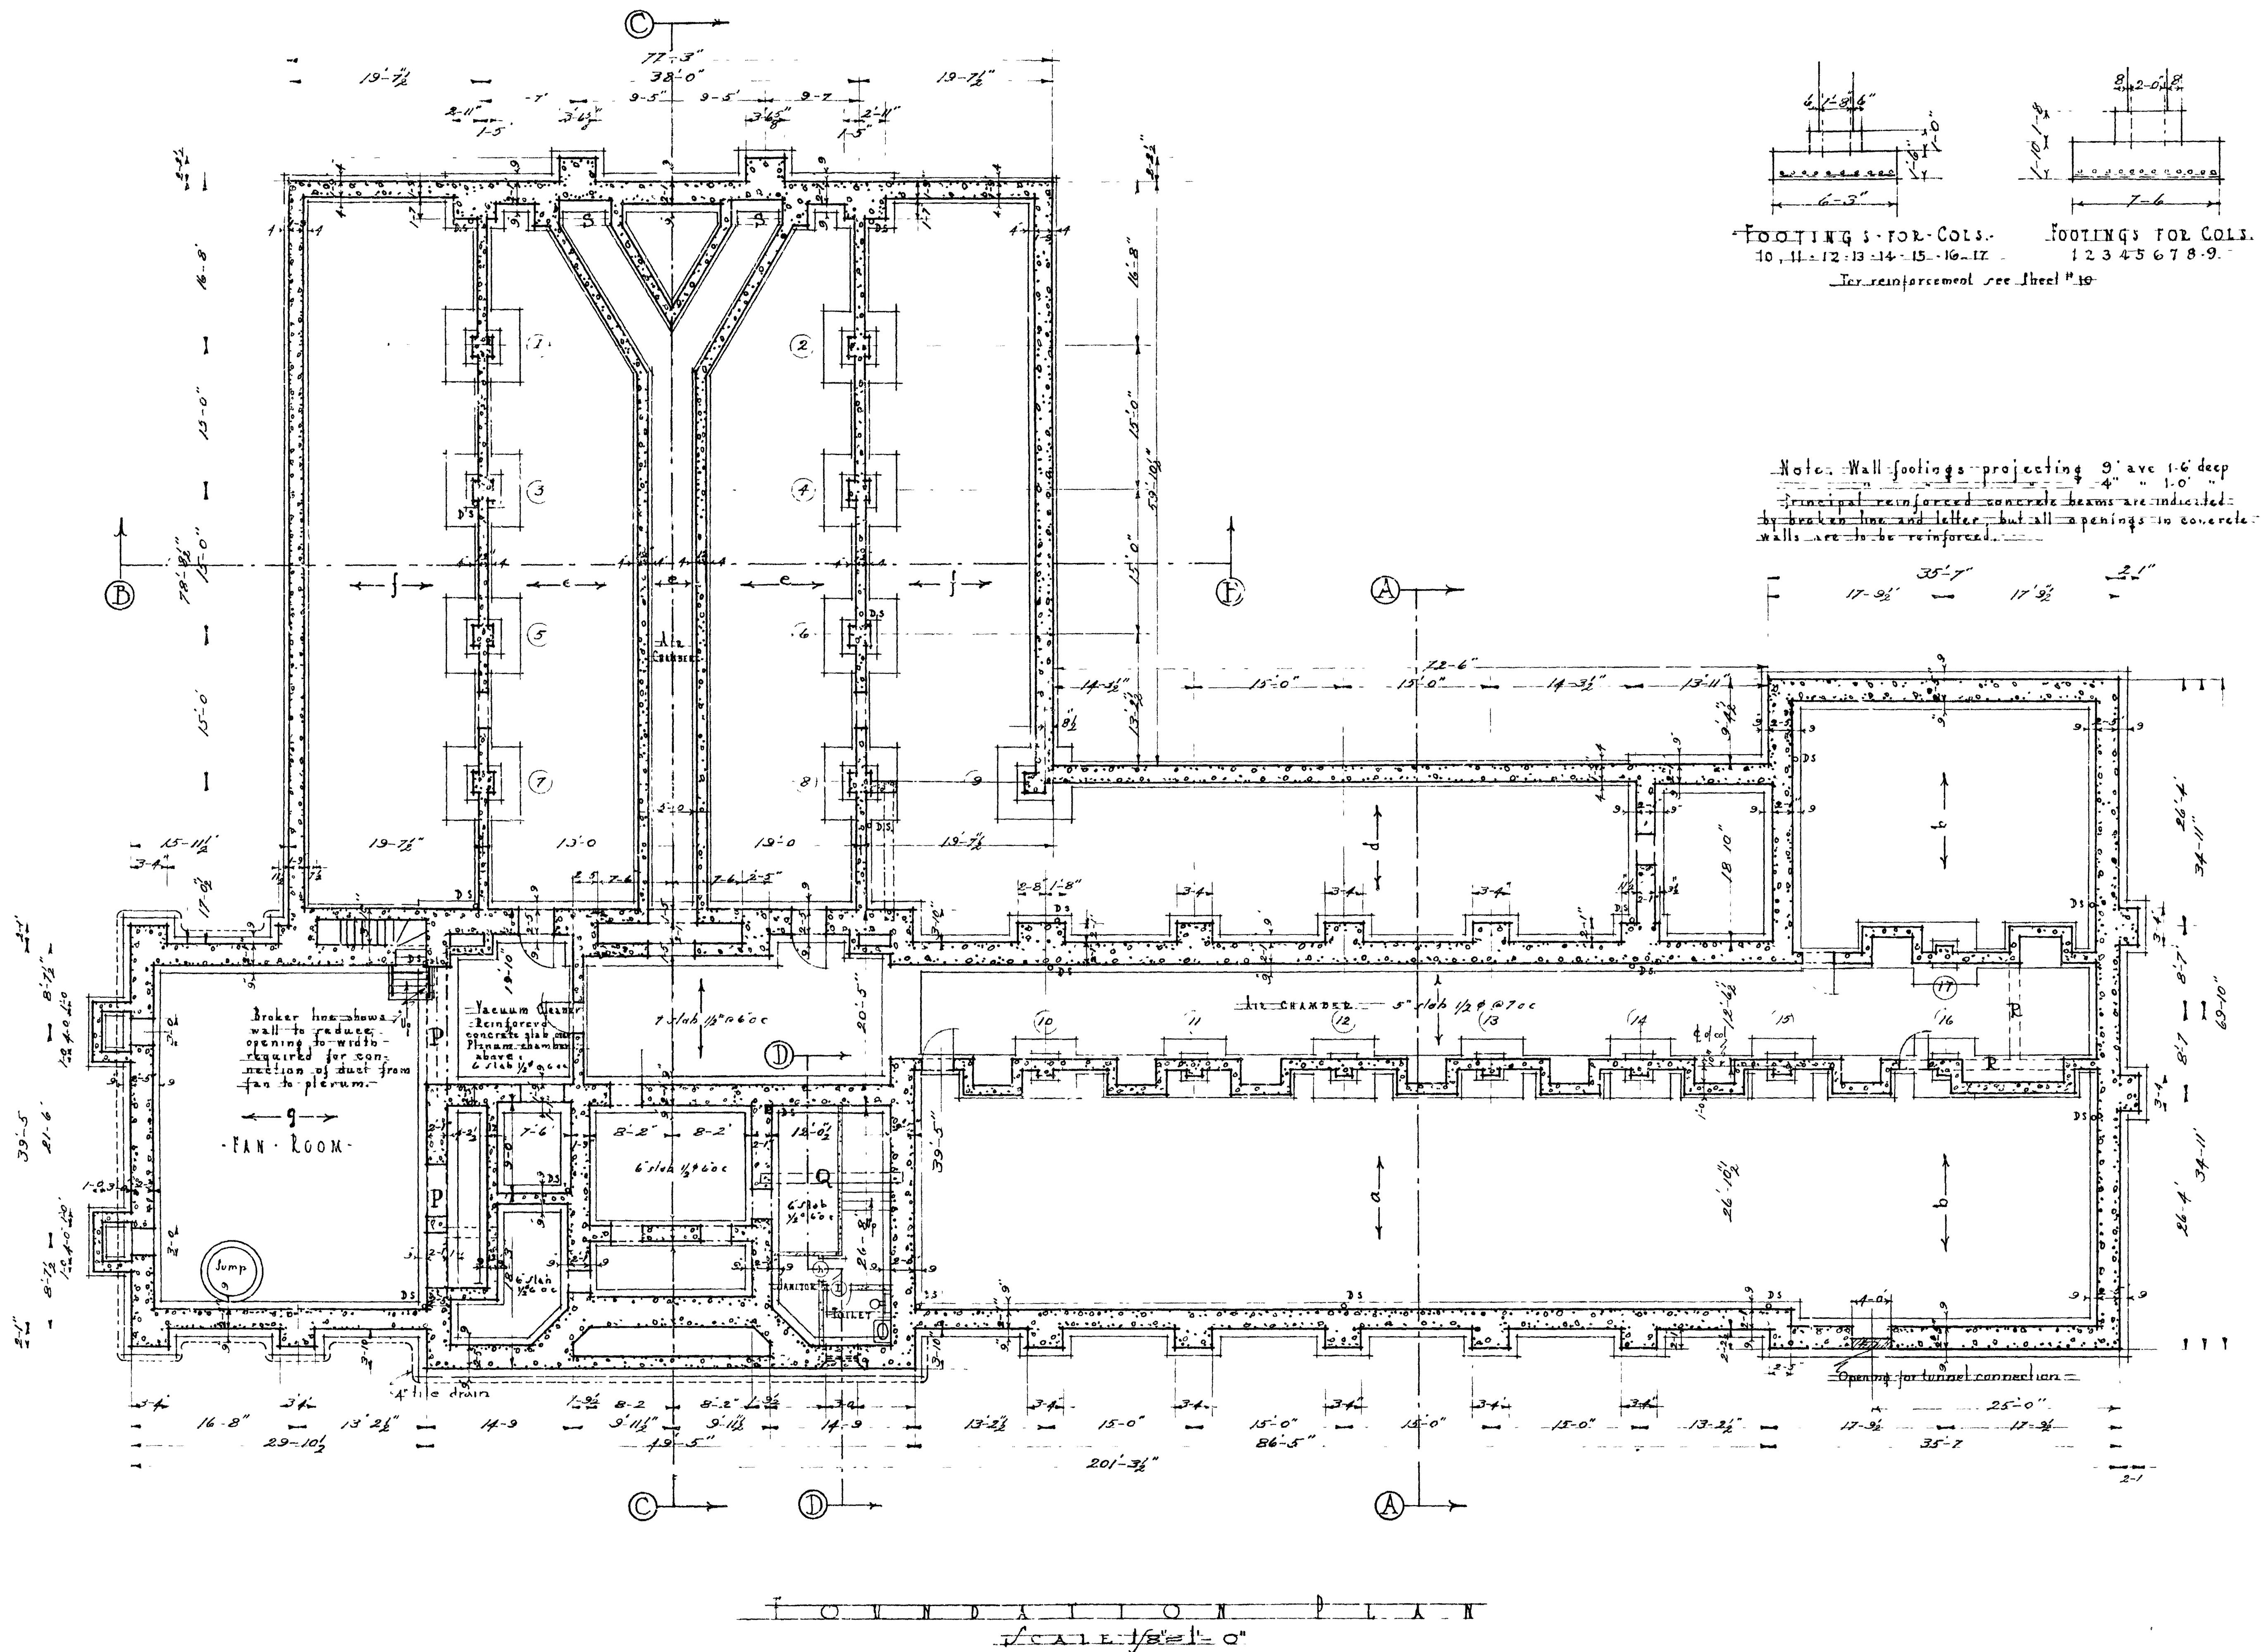

FOOTINGS FOR COLS. 10, 11, 12, 13, 14, 15, 16, 17. 1 2 3 4 5 6 7 8 9.
For reinforcement see sheet # 10

For reinforcement see sheet #10


Note. Wall footings projecting 9' are 1-6' deep
" " " 4" " 1-0" "
Principal reinforced concrete beams are indicated
by broken line and letter, but all openings in concrete
walls are to be reinforced.

Hand-drawn architectural floor plan of a building with the following dimensions and features:

- Overall width: 35'-7"
- Side sections: 17'-9"
- Central section: 26'-4"
- Right side section: 34'-11"
- Bottom section: 69'-10"
- Bottom opening: 25'-0"
- Rooms labeled: 15, 16, 17, 18, 19
- Staircase indicated
- Notes: "Opening for tunnel connection" at the bottom

FOUNDA~~TION~~ PLANNING
SCALE 1" = 0"

COLLEGE OF EDUCATION, CHICAGO

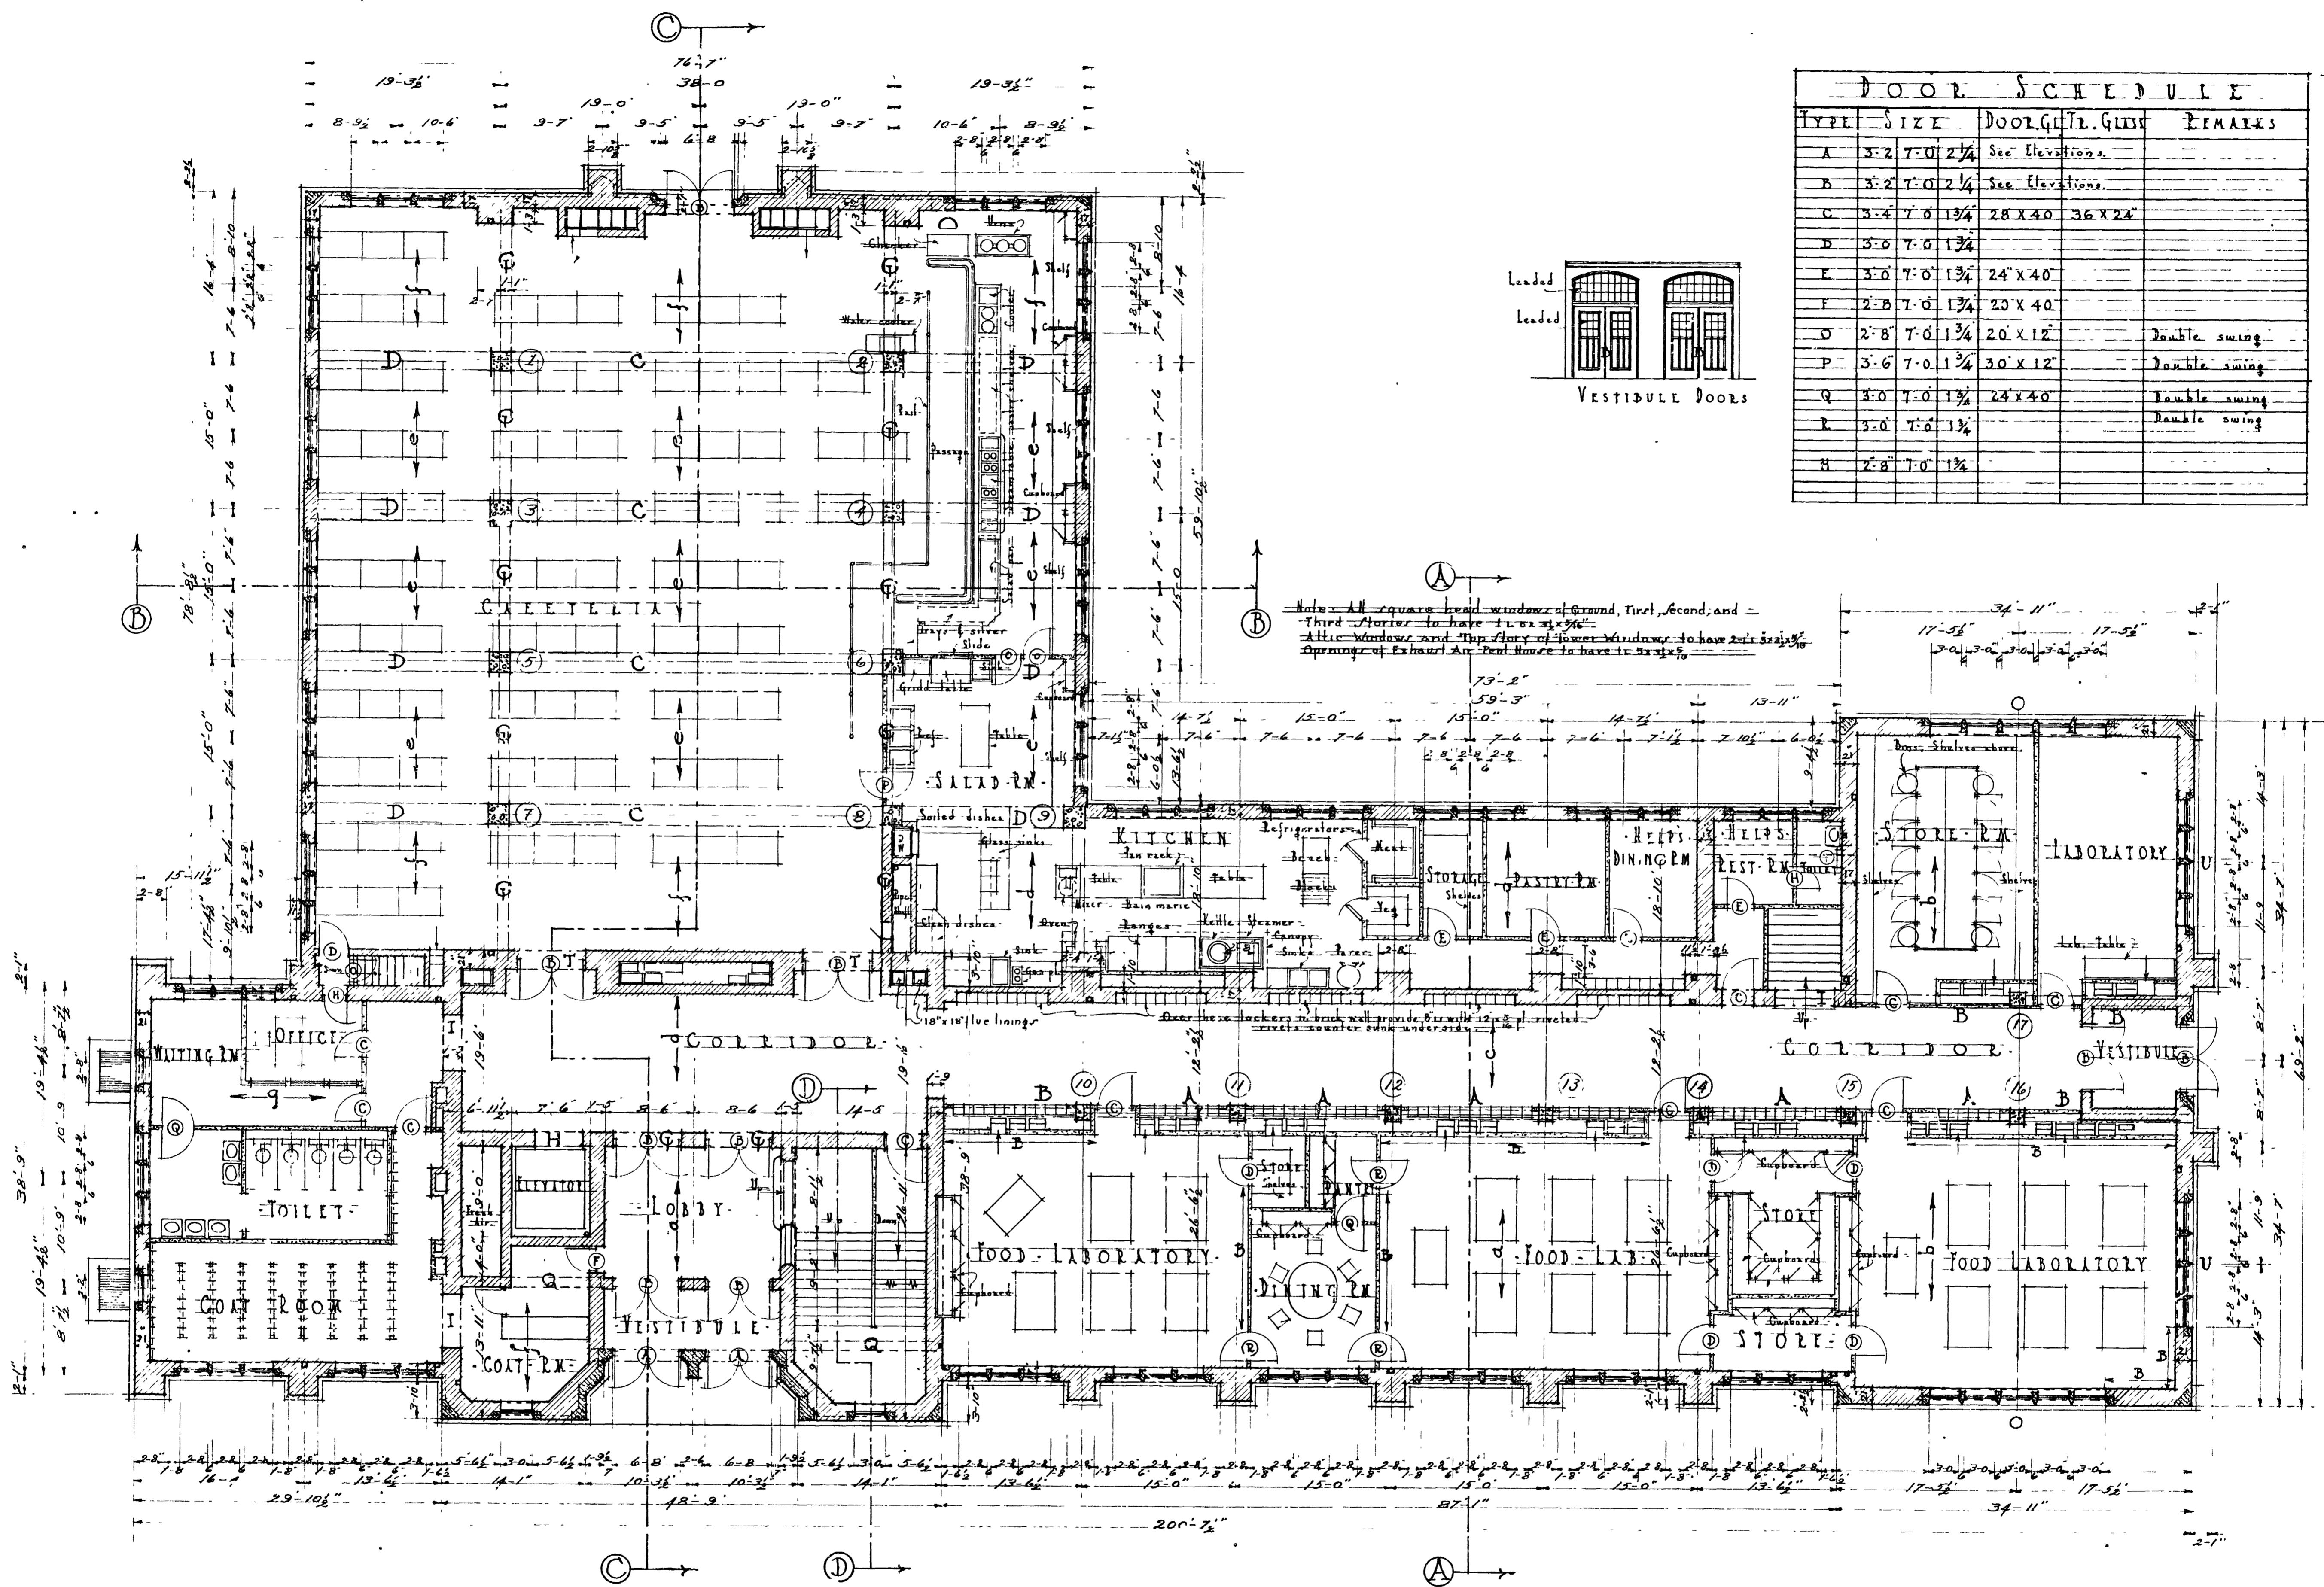


DOOR SCHEDULE

TYPE	SIZE	DOOR GLT. GLSS	REMARKS
A	3-2 7-0 2 1/4	See Elevations.	
B	3-2 7-0 2 1/4	See Elevations.	
C	3-4 7-0 1 3/4	28 X 40 36 X 24"	
D	3-0 7-0 1 3/4		
E	3-0 7-0 1 3/4	24" X 40	
F	2-8 7-0 1 3/4	20 X 40	
O	2-8 7-0 1 3/4	20 X 12	Double swing
P	3-6 7-0 1 3/4	30 X 12	Double swing
Q	3-0 7-0 1 3/4	24 X 40	Double swing
R	3-0 7-0 1 3/4		Double swing
M	2-8 7-0 1 3/4		


Ground floor plan

Home Economics

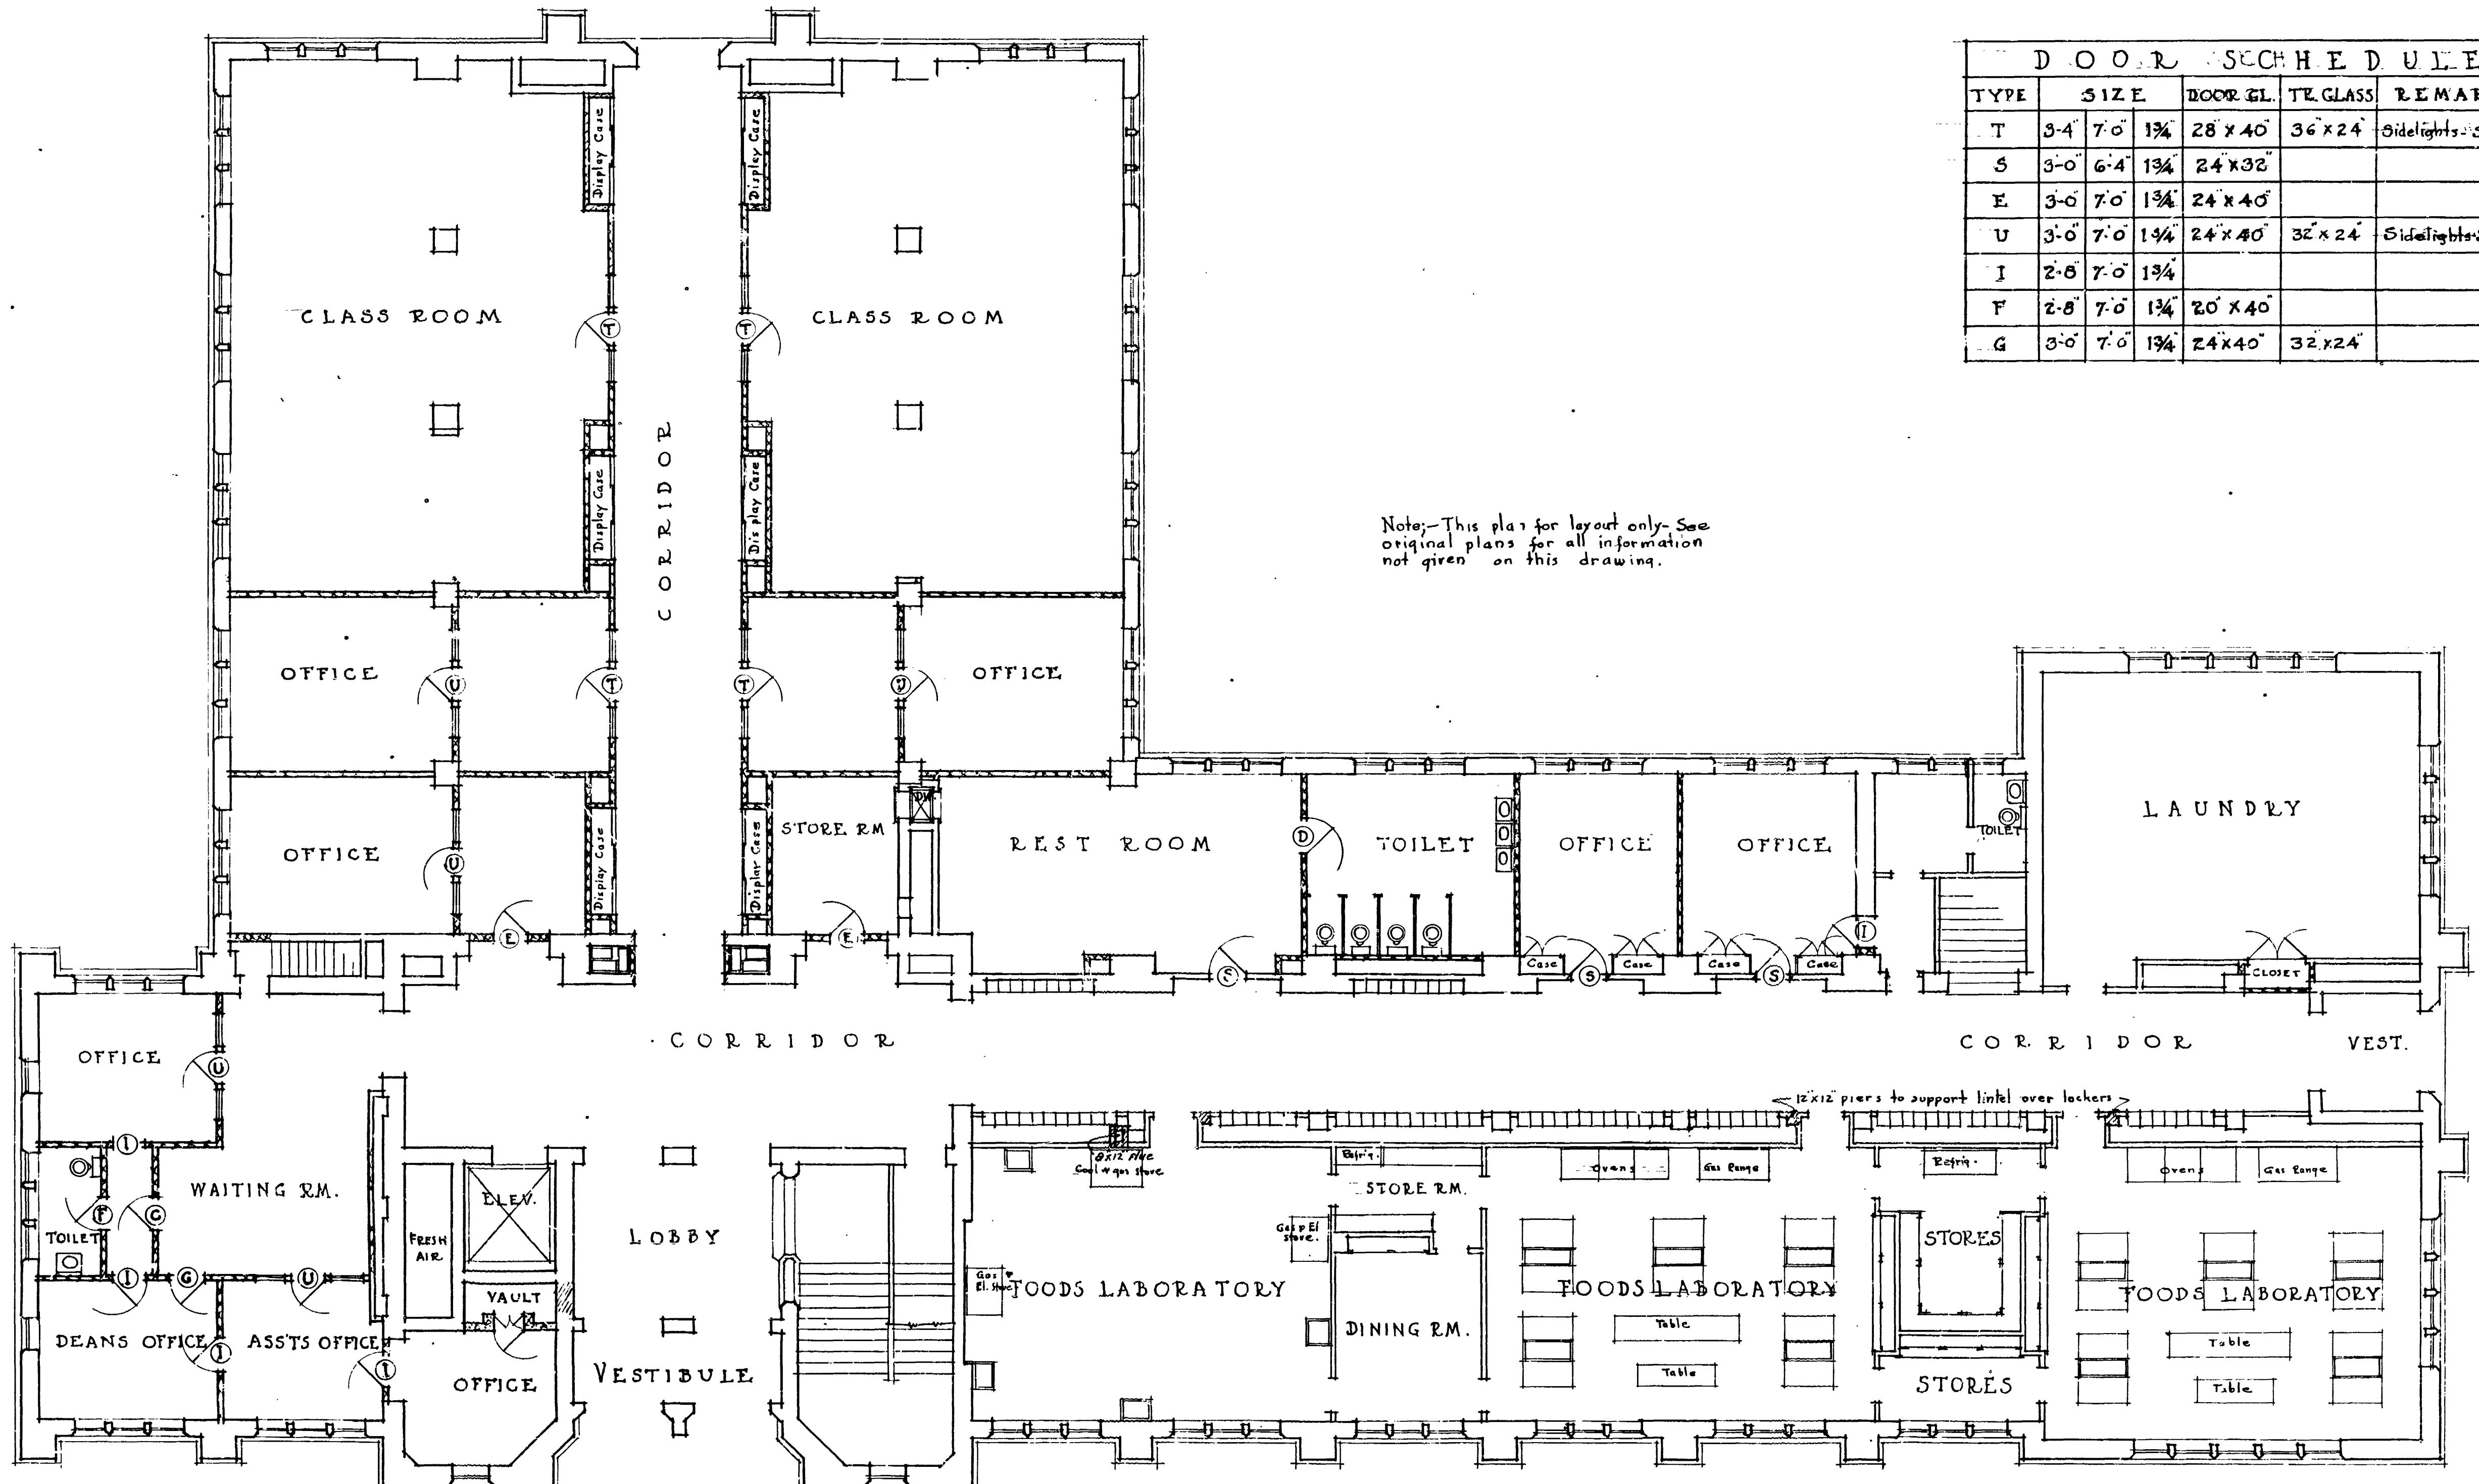


REVISED
GROUND FLOOR PLAN
SCALE $1/8" = 1:0"$

HOME ECONOMICS BUILDING
MICHIGAN AGRICULTURAL COLLEGE, EAST LANSING
EDWYN A. BOWD, ARCHITECT. LANSING, MICHIGAN

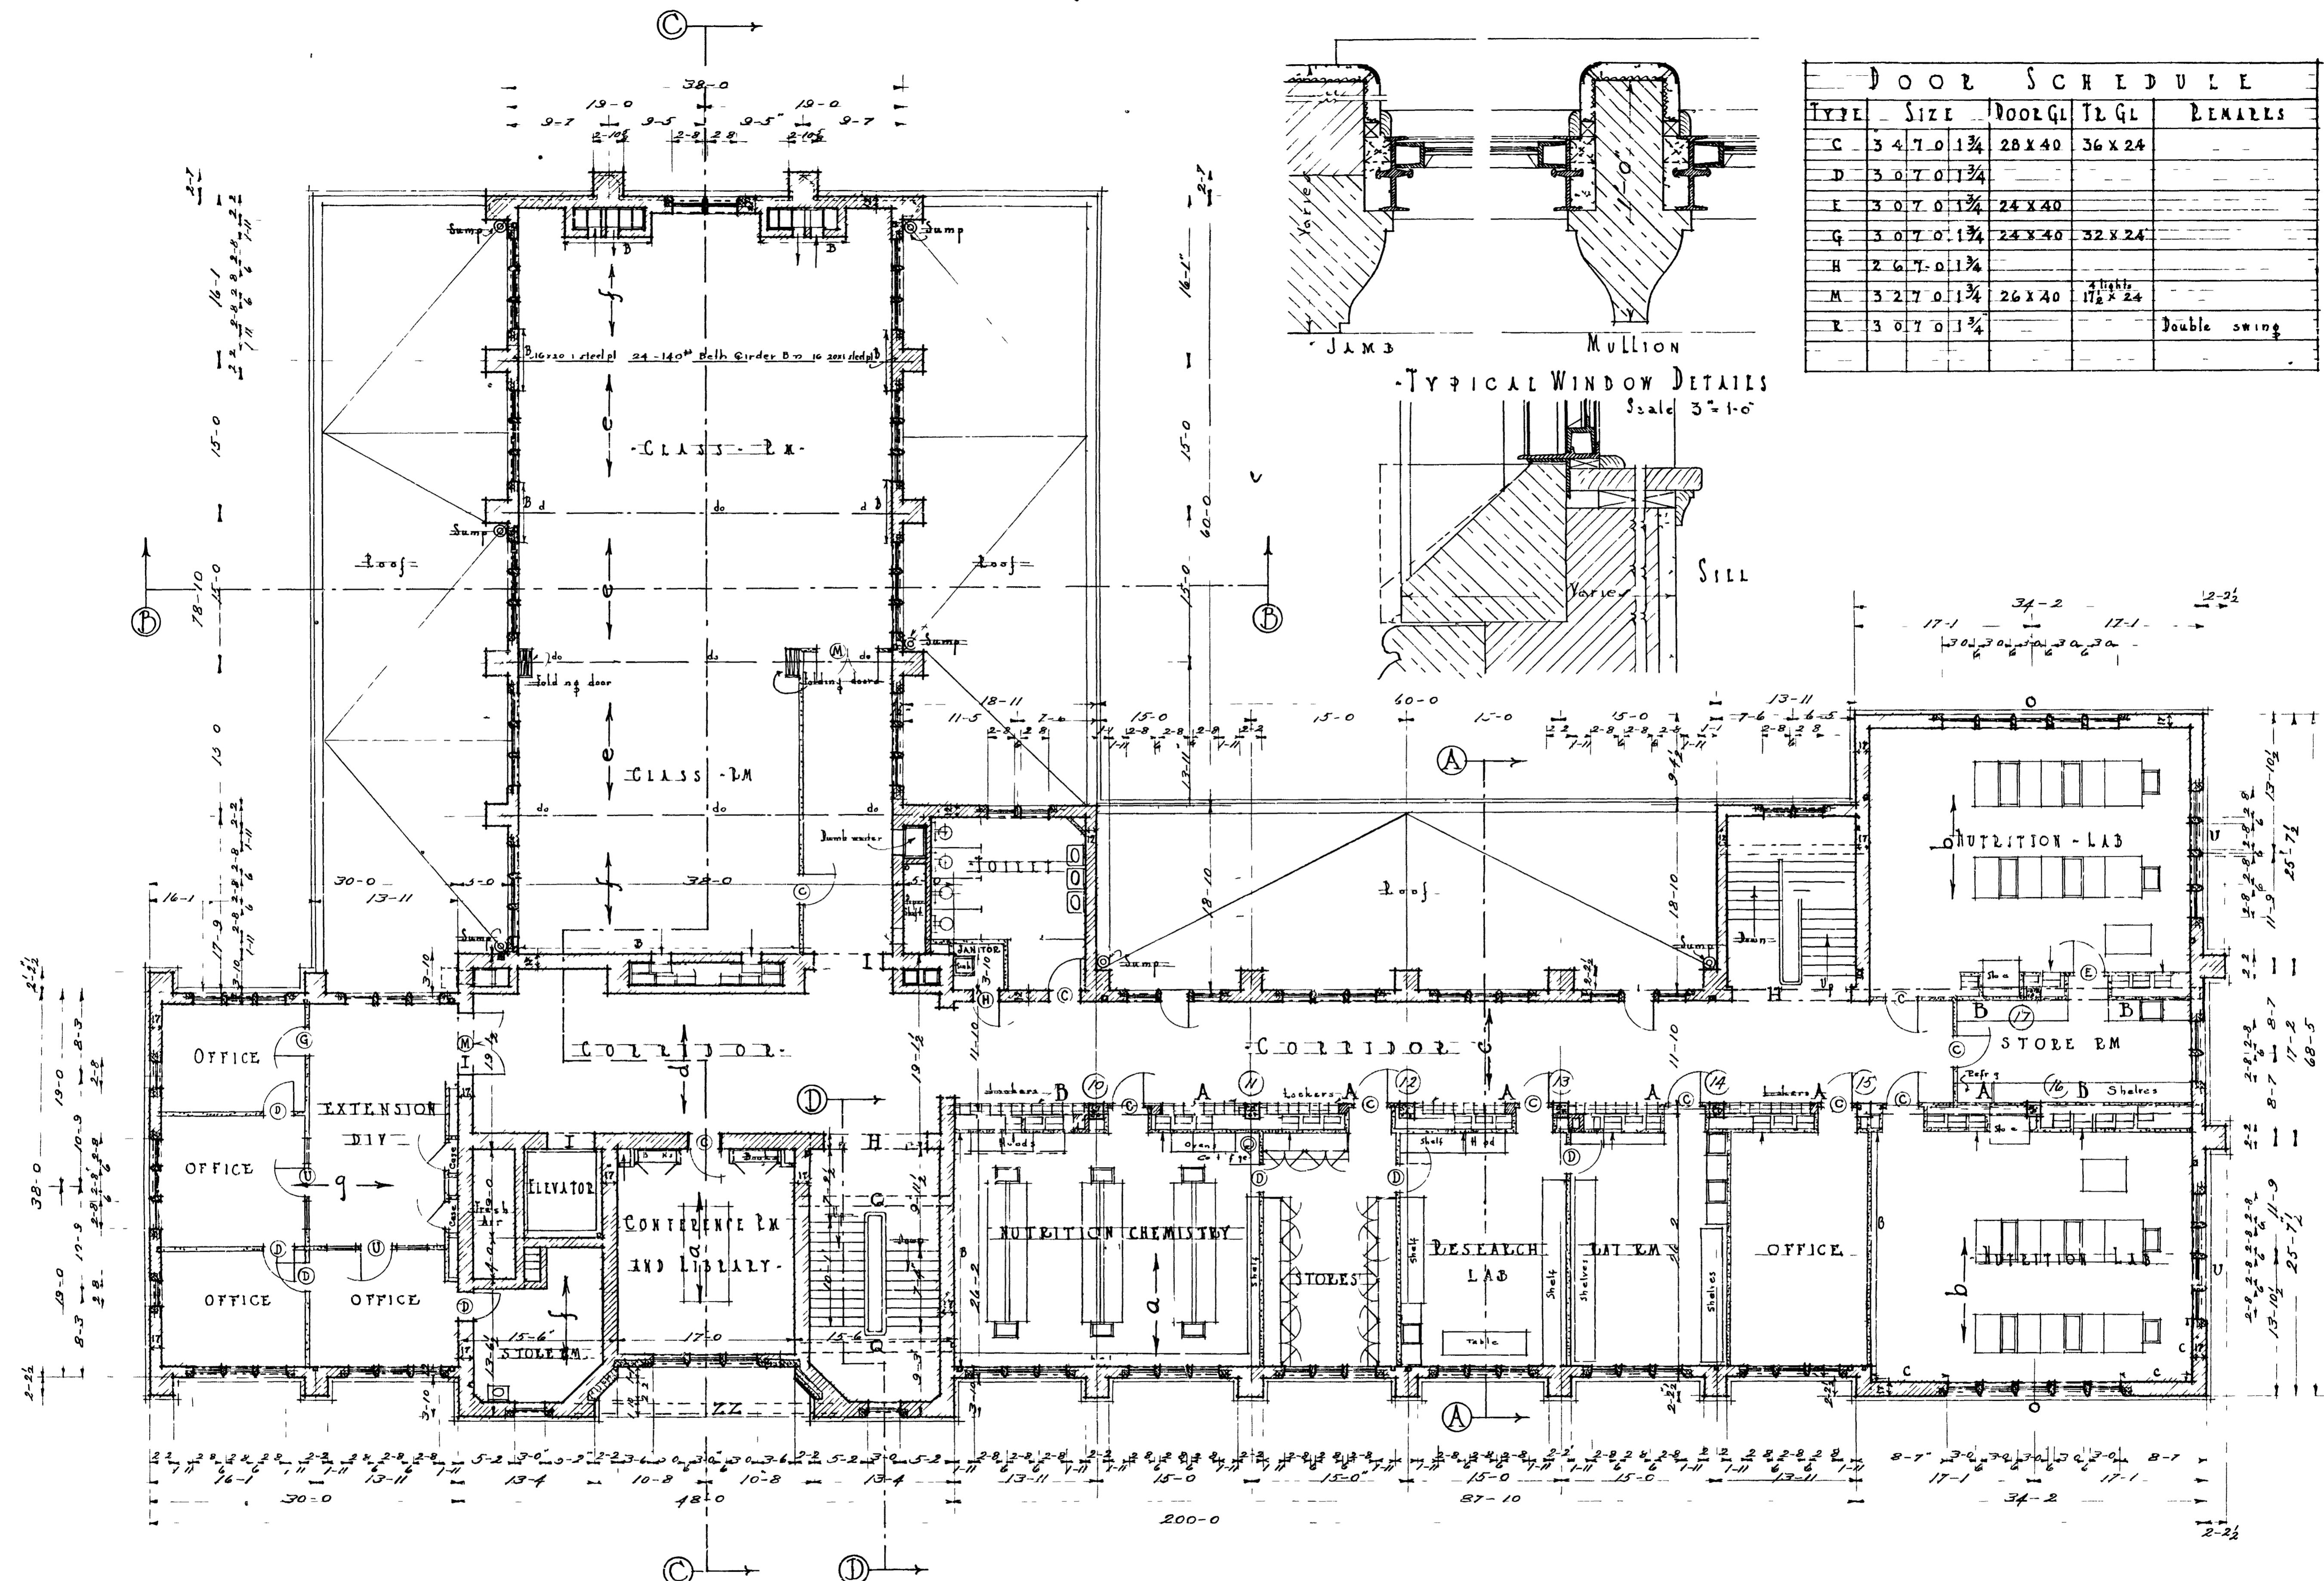


REVISED

1100
FACT 1/8" = 1-0"

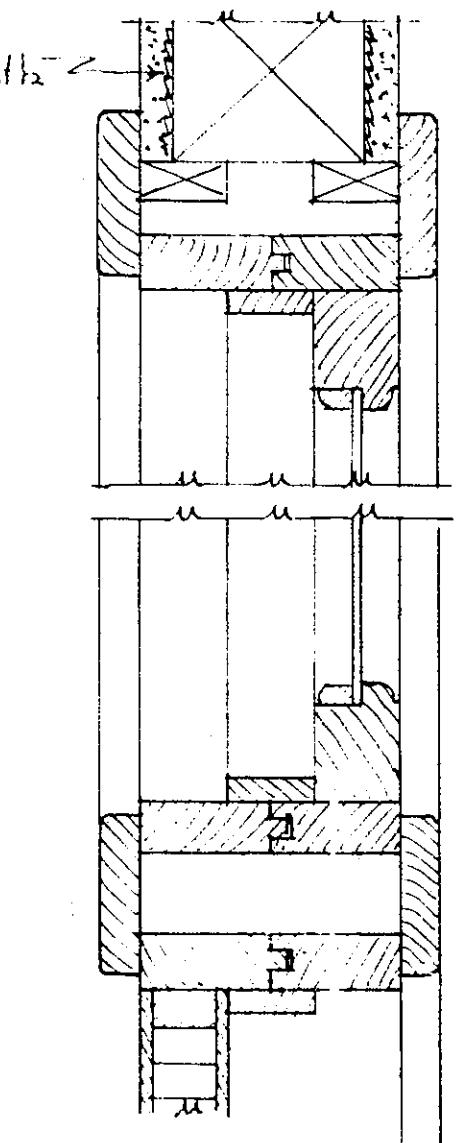


HEAD.

TRANSOM
BAR

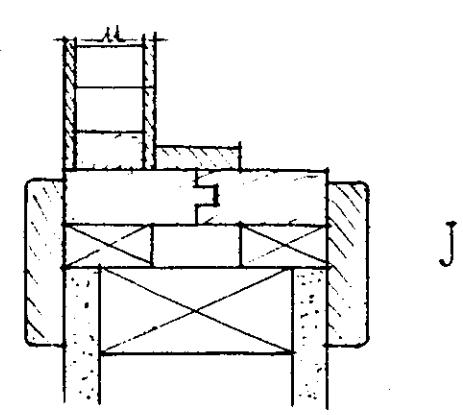


JAMB




TYPICAL INSIDE
DOOR FRAMES
Scale 3'-0"

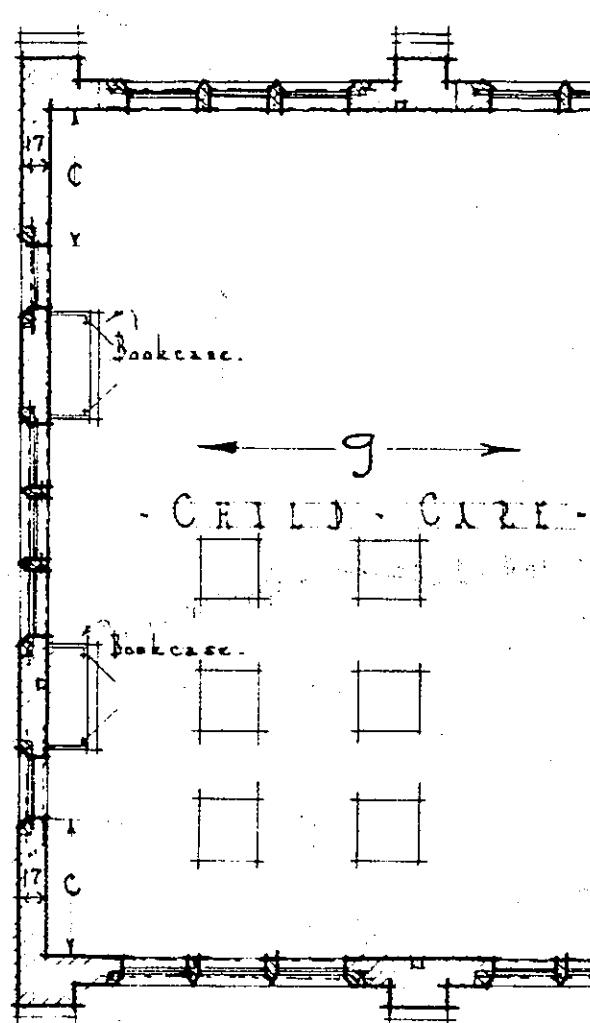




CRIB - CAGE

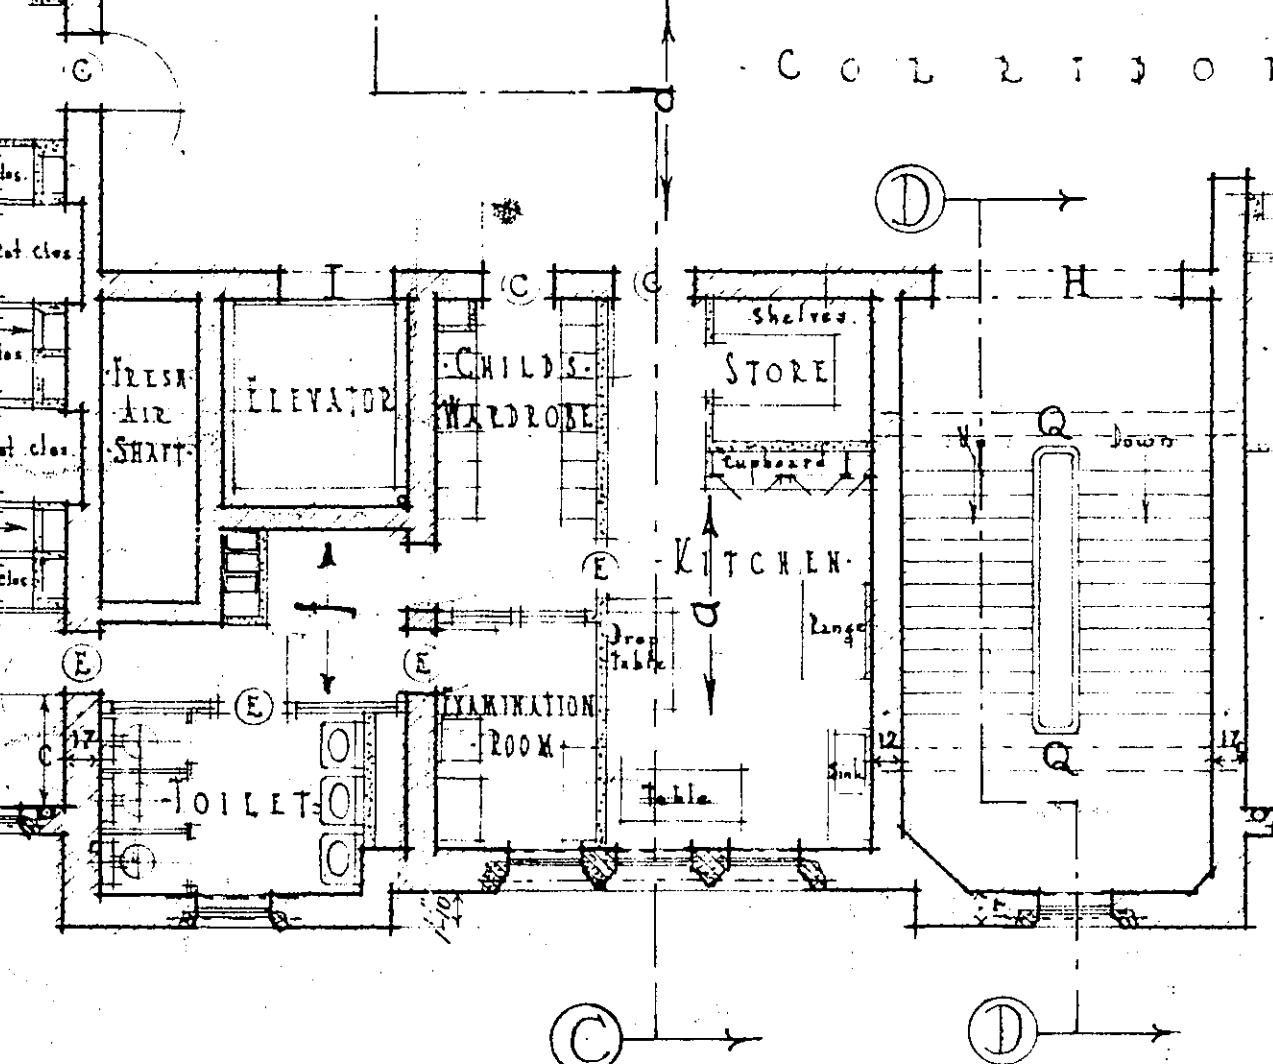

SECOND FLOOR PLAN
Scale 1/8" = 1'-0"

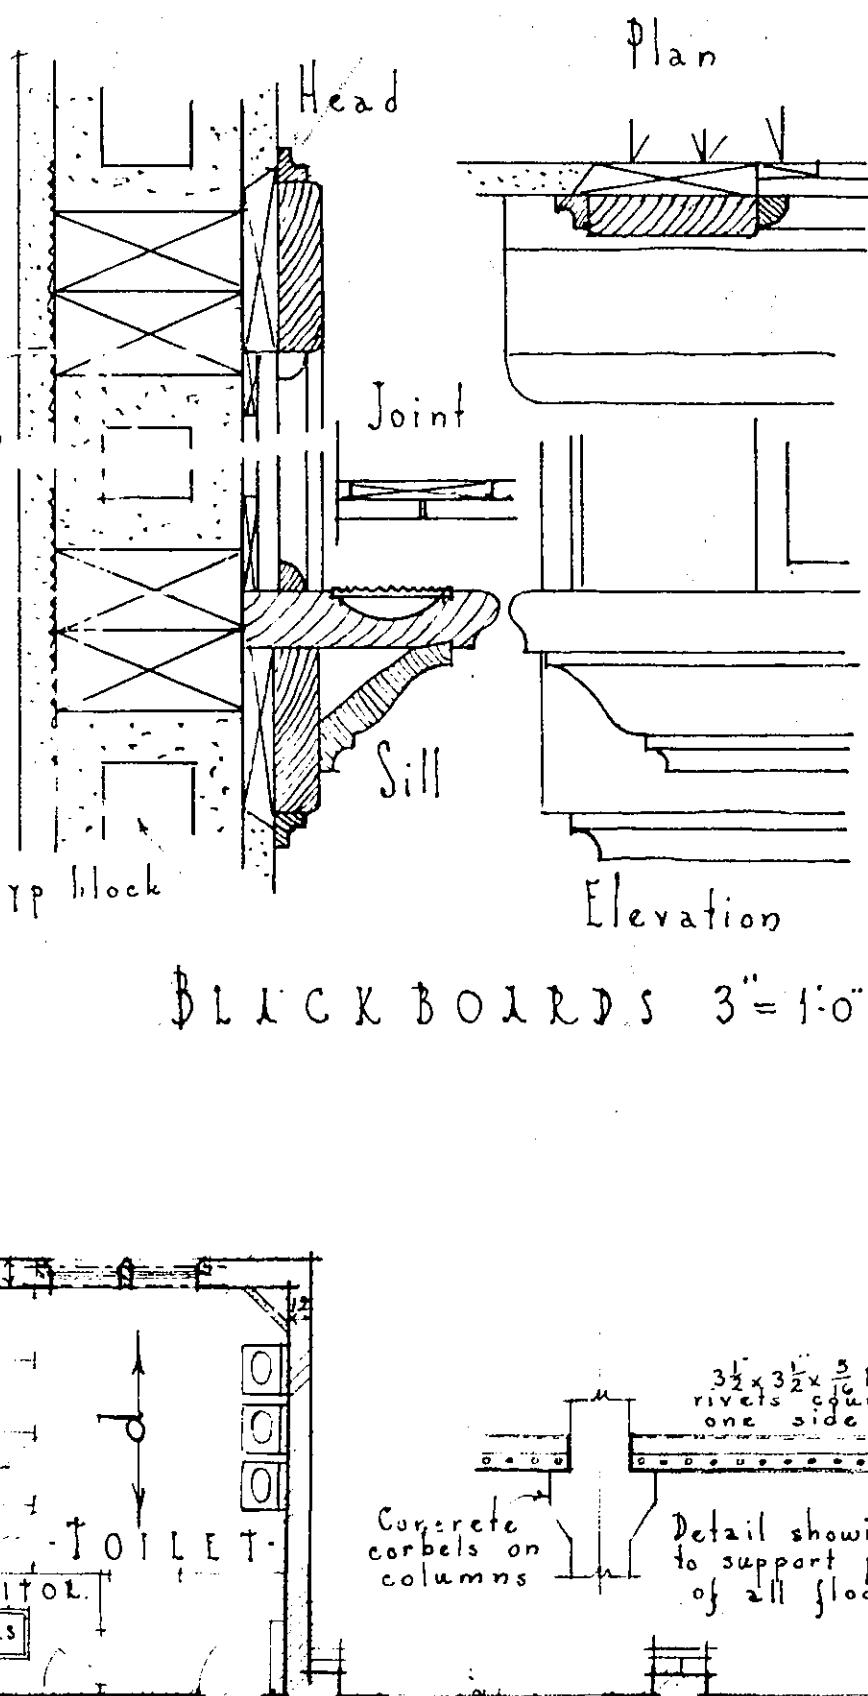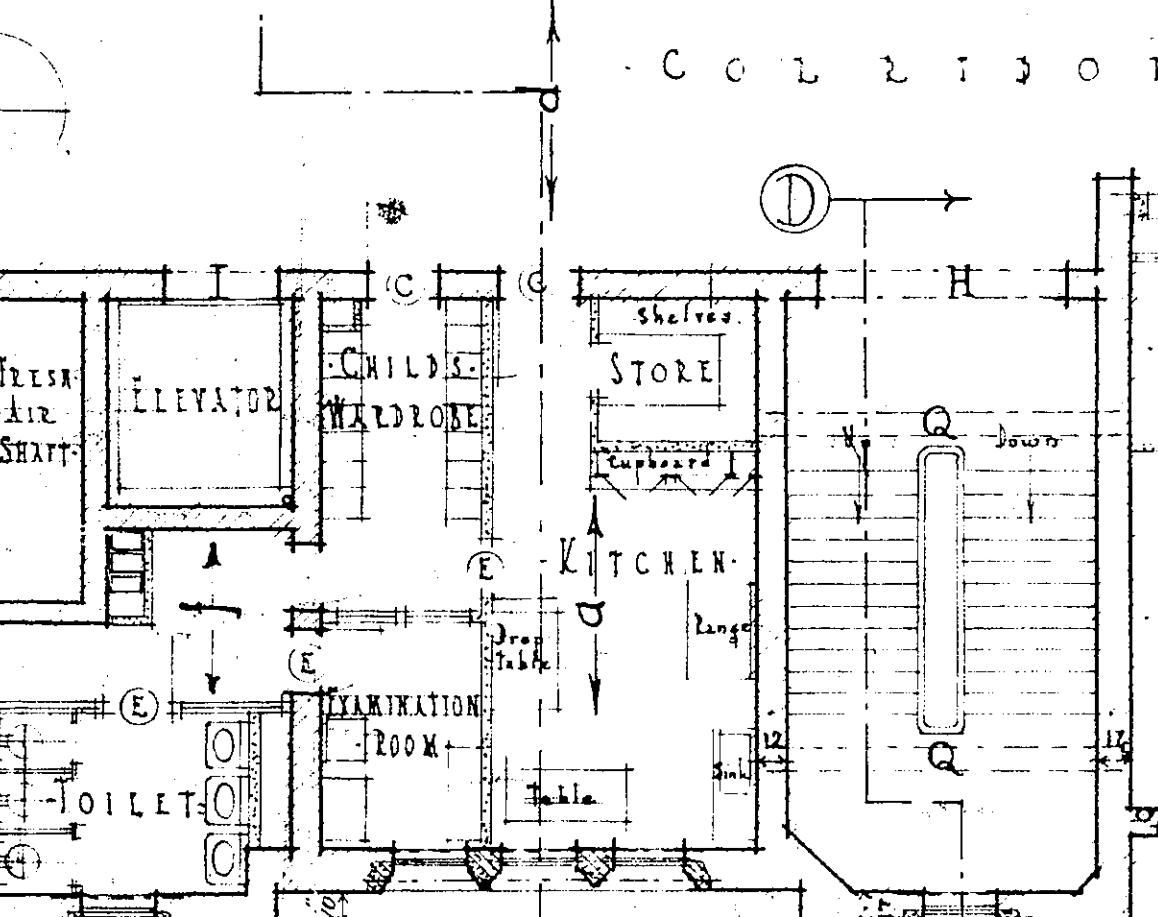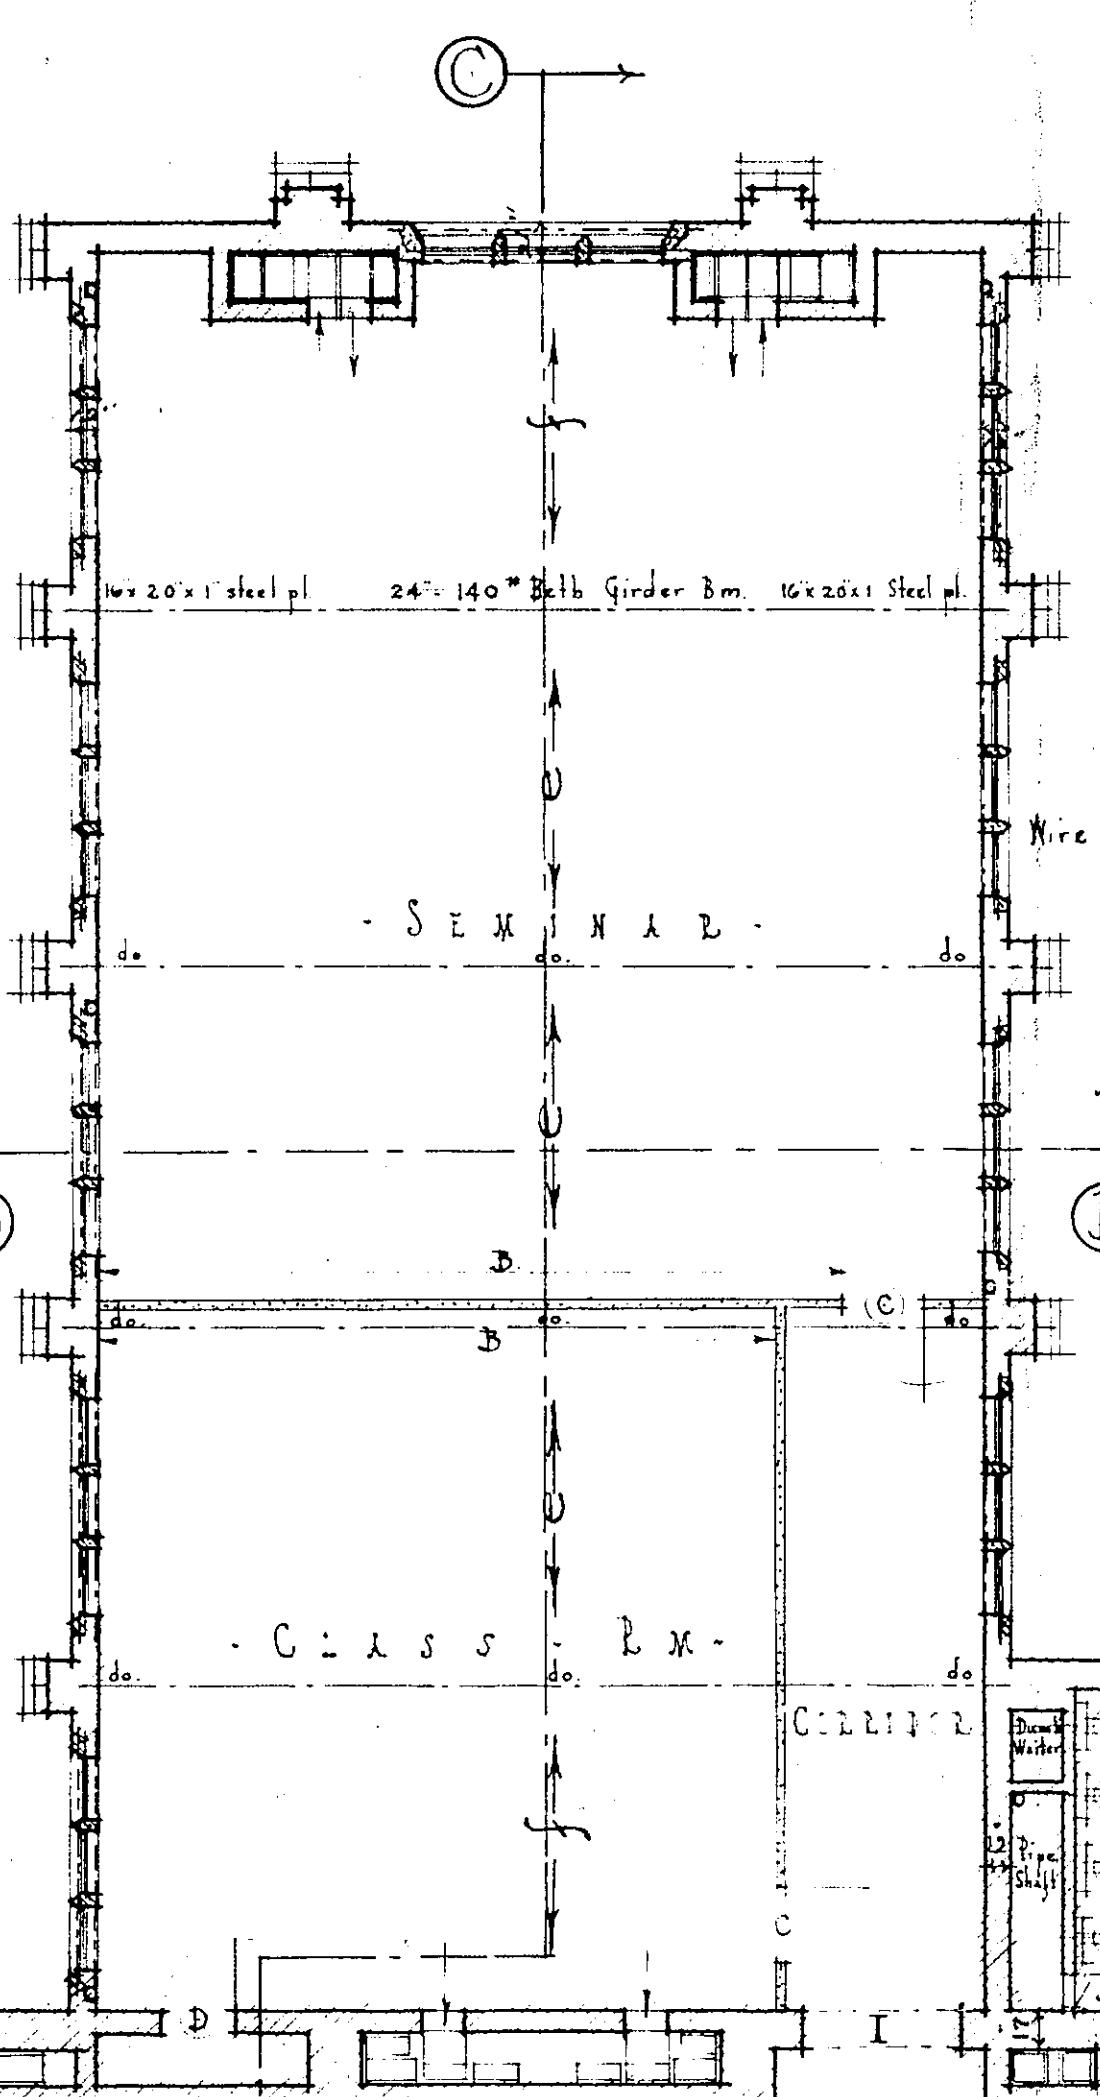

FULL SIZE
DETAIL OF BASE

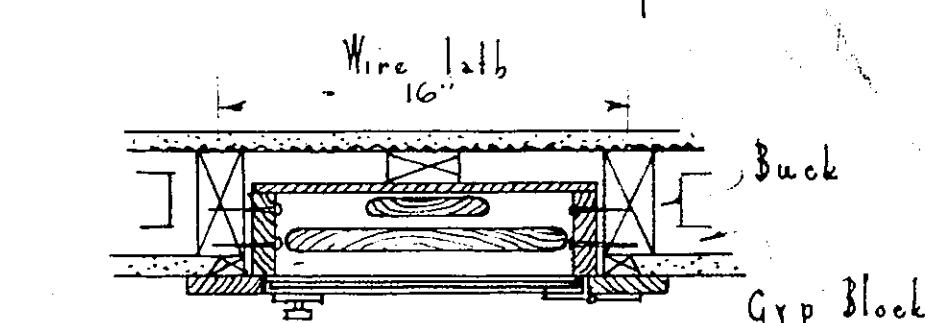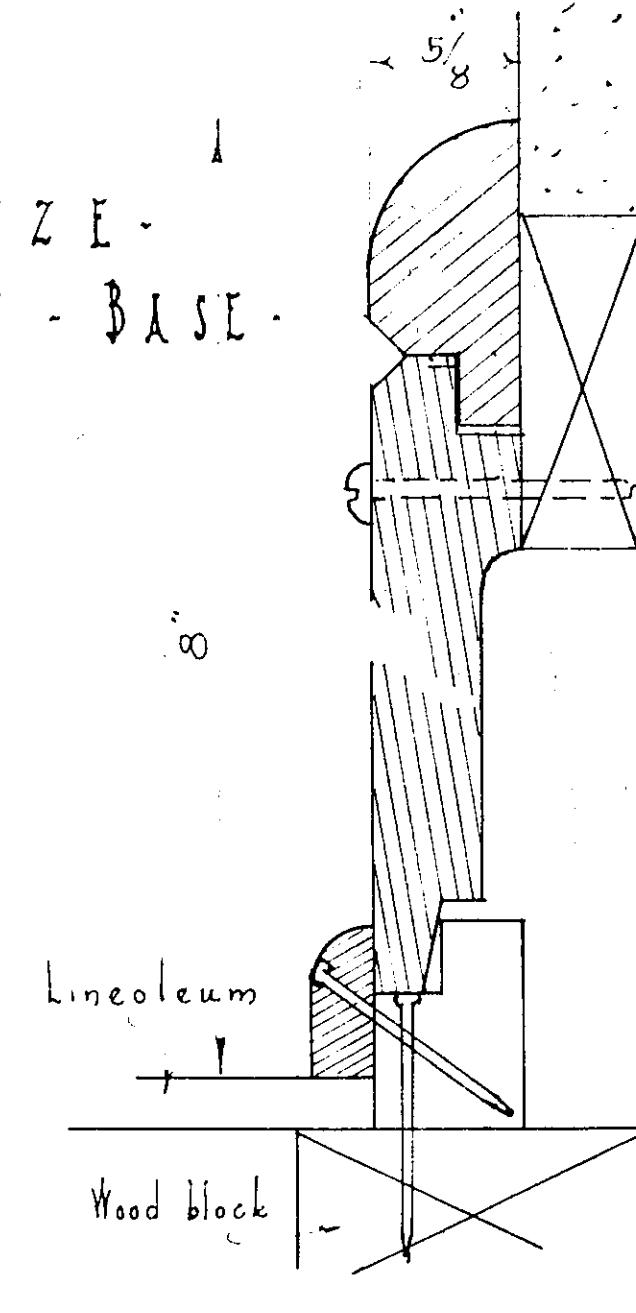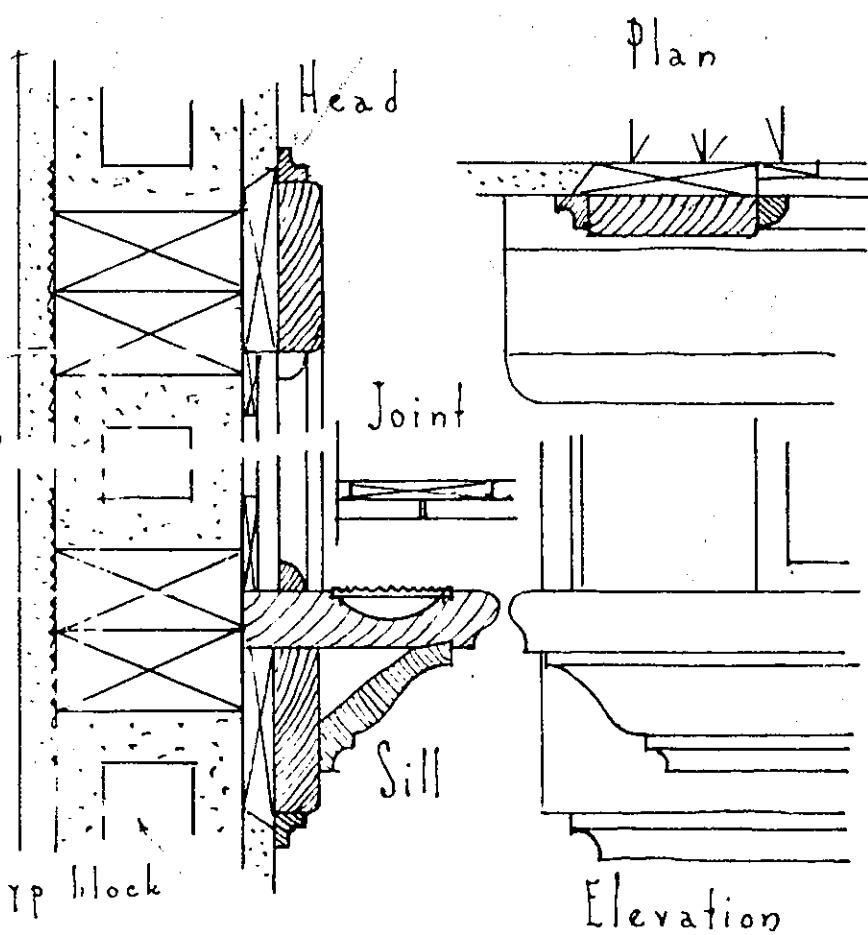


IRONING BOARD


BLOCK BOARDS 3'-0"


Scale 1/2" = 1'-0"
Concrete corbels on columns
Detail showing channel with angle iron
to support partition over lockers
of all floors.

CORRIDOR

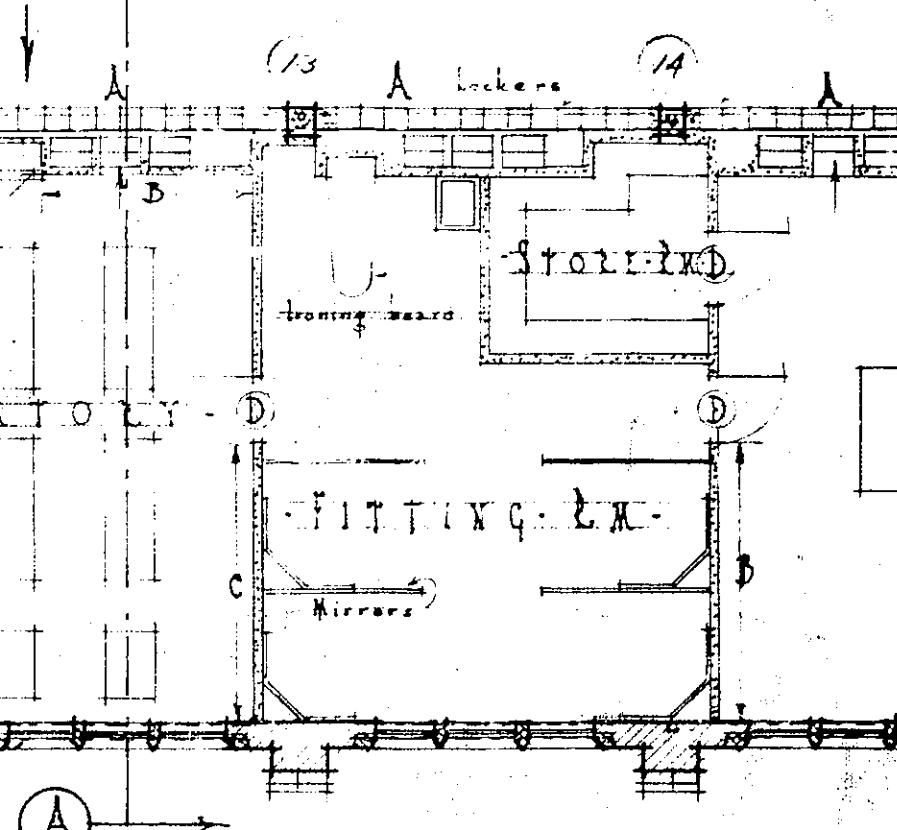


DOOR SCHEDULE			
TYPE	SIZE	DOOR GLASS	NOTES
C	3'-4" 7'-0" 1 1/4	28 X 40	36 X 24
D	3'-0" 7'-0" 1 1/4		
E	3'-0" 7'-0" 1 1/4	24 X 40	
H	2'-6" 7'-0" 1 1/4		

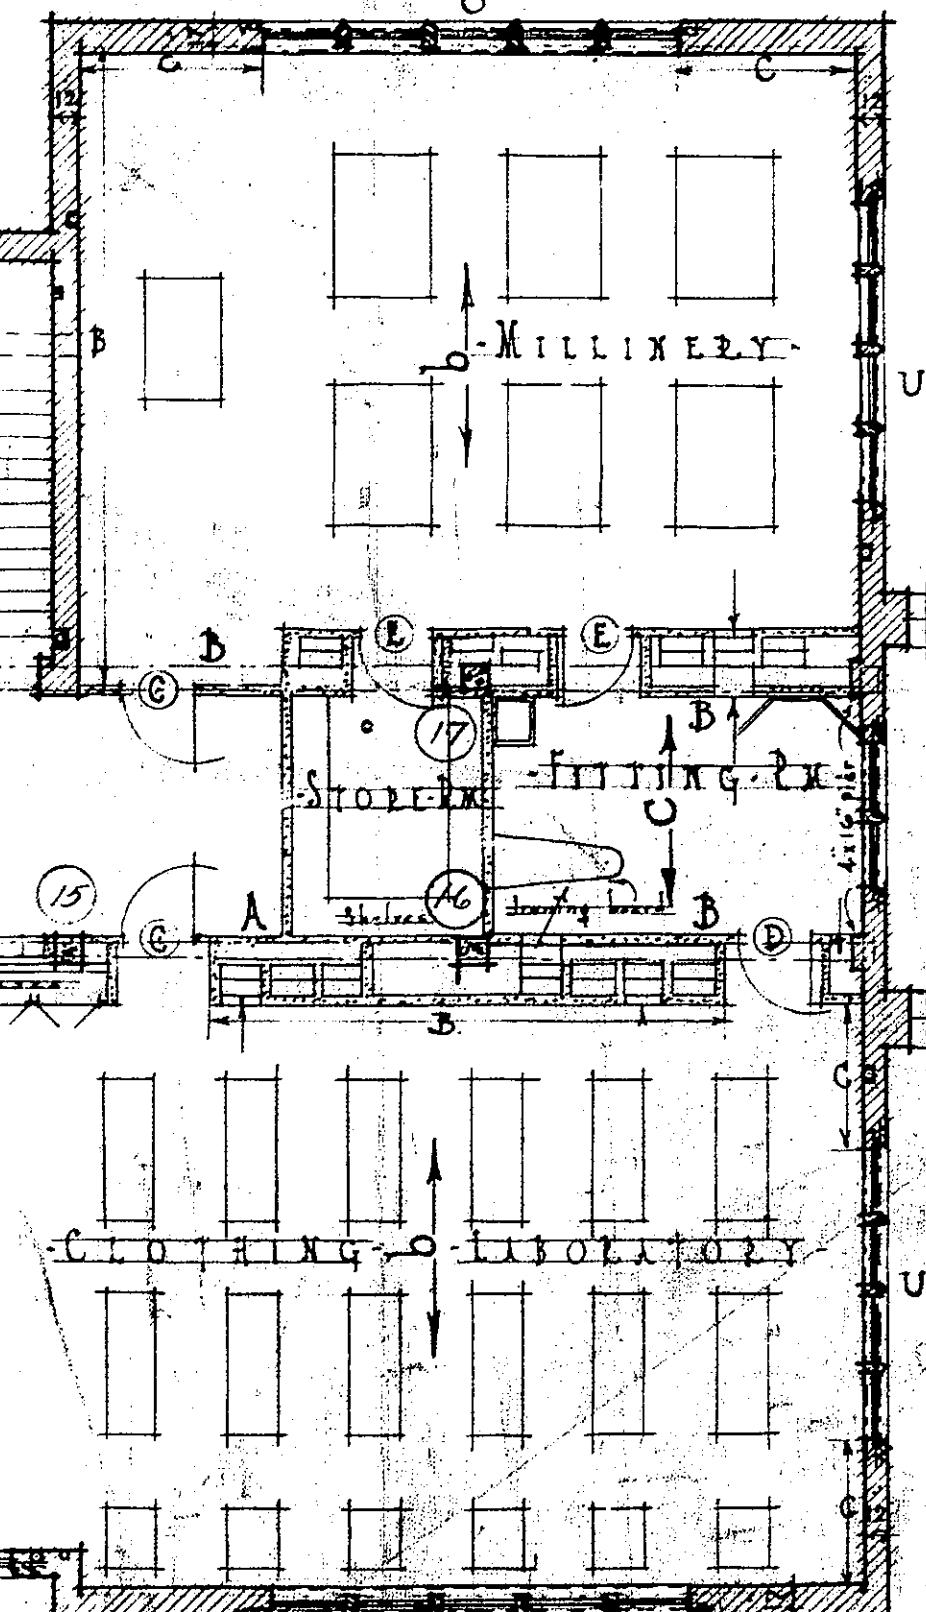

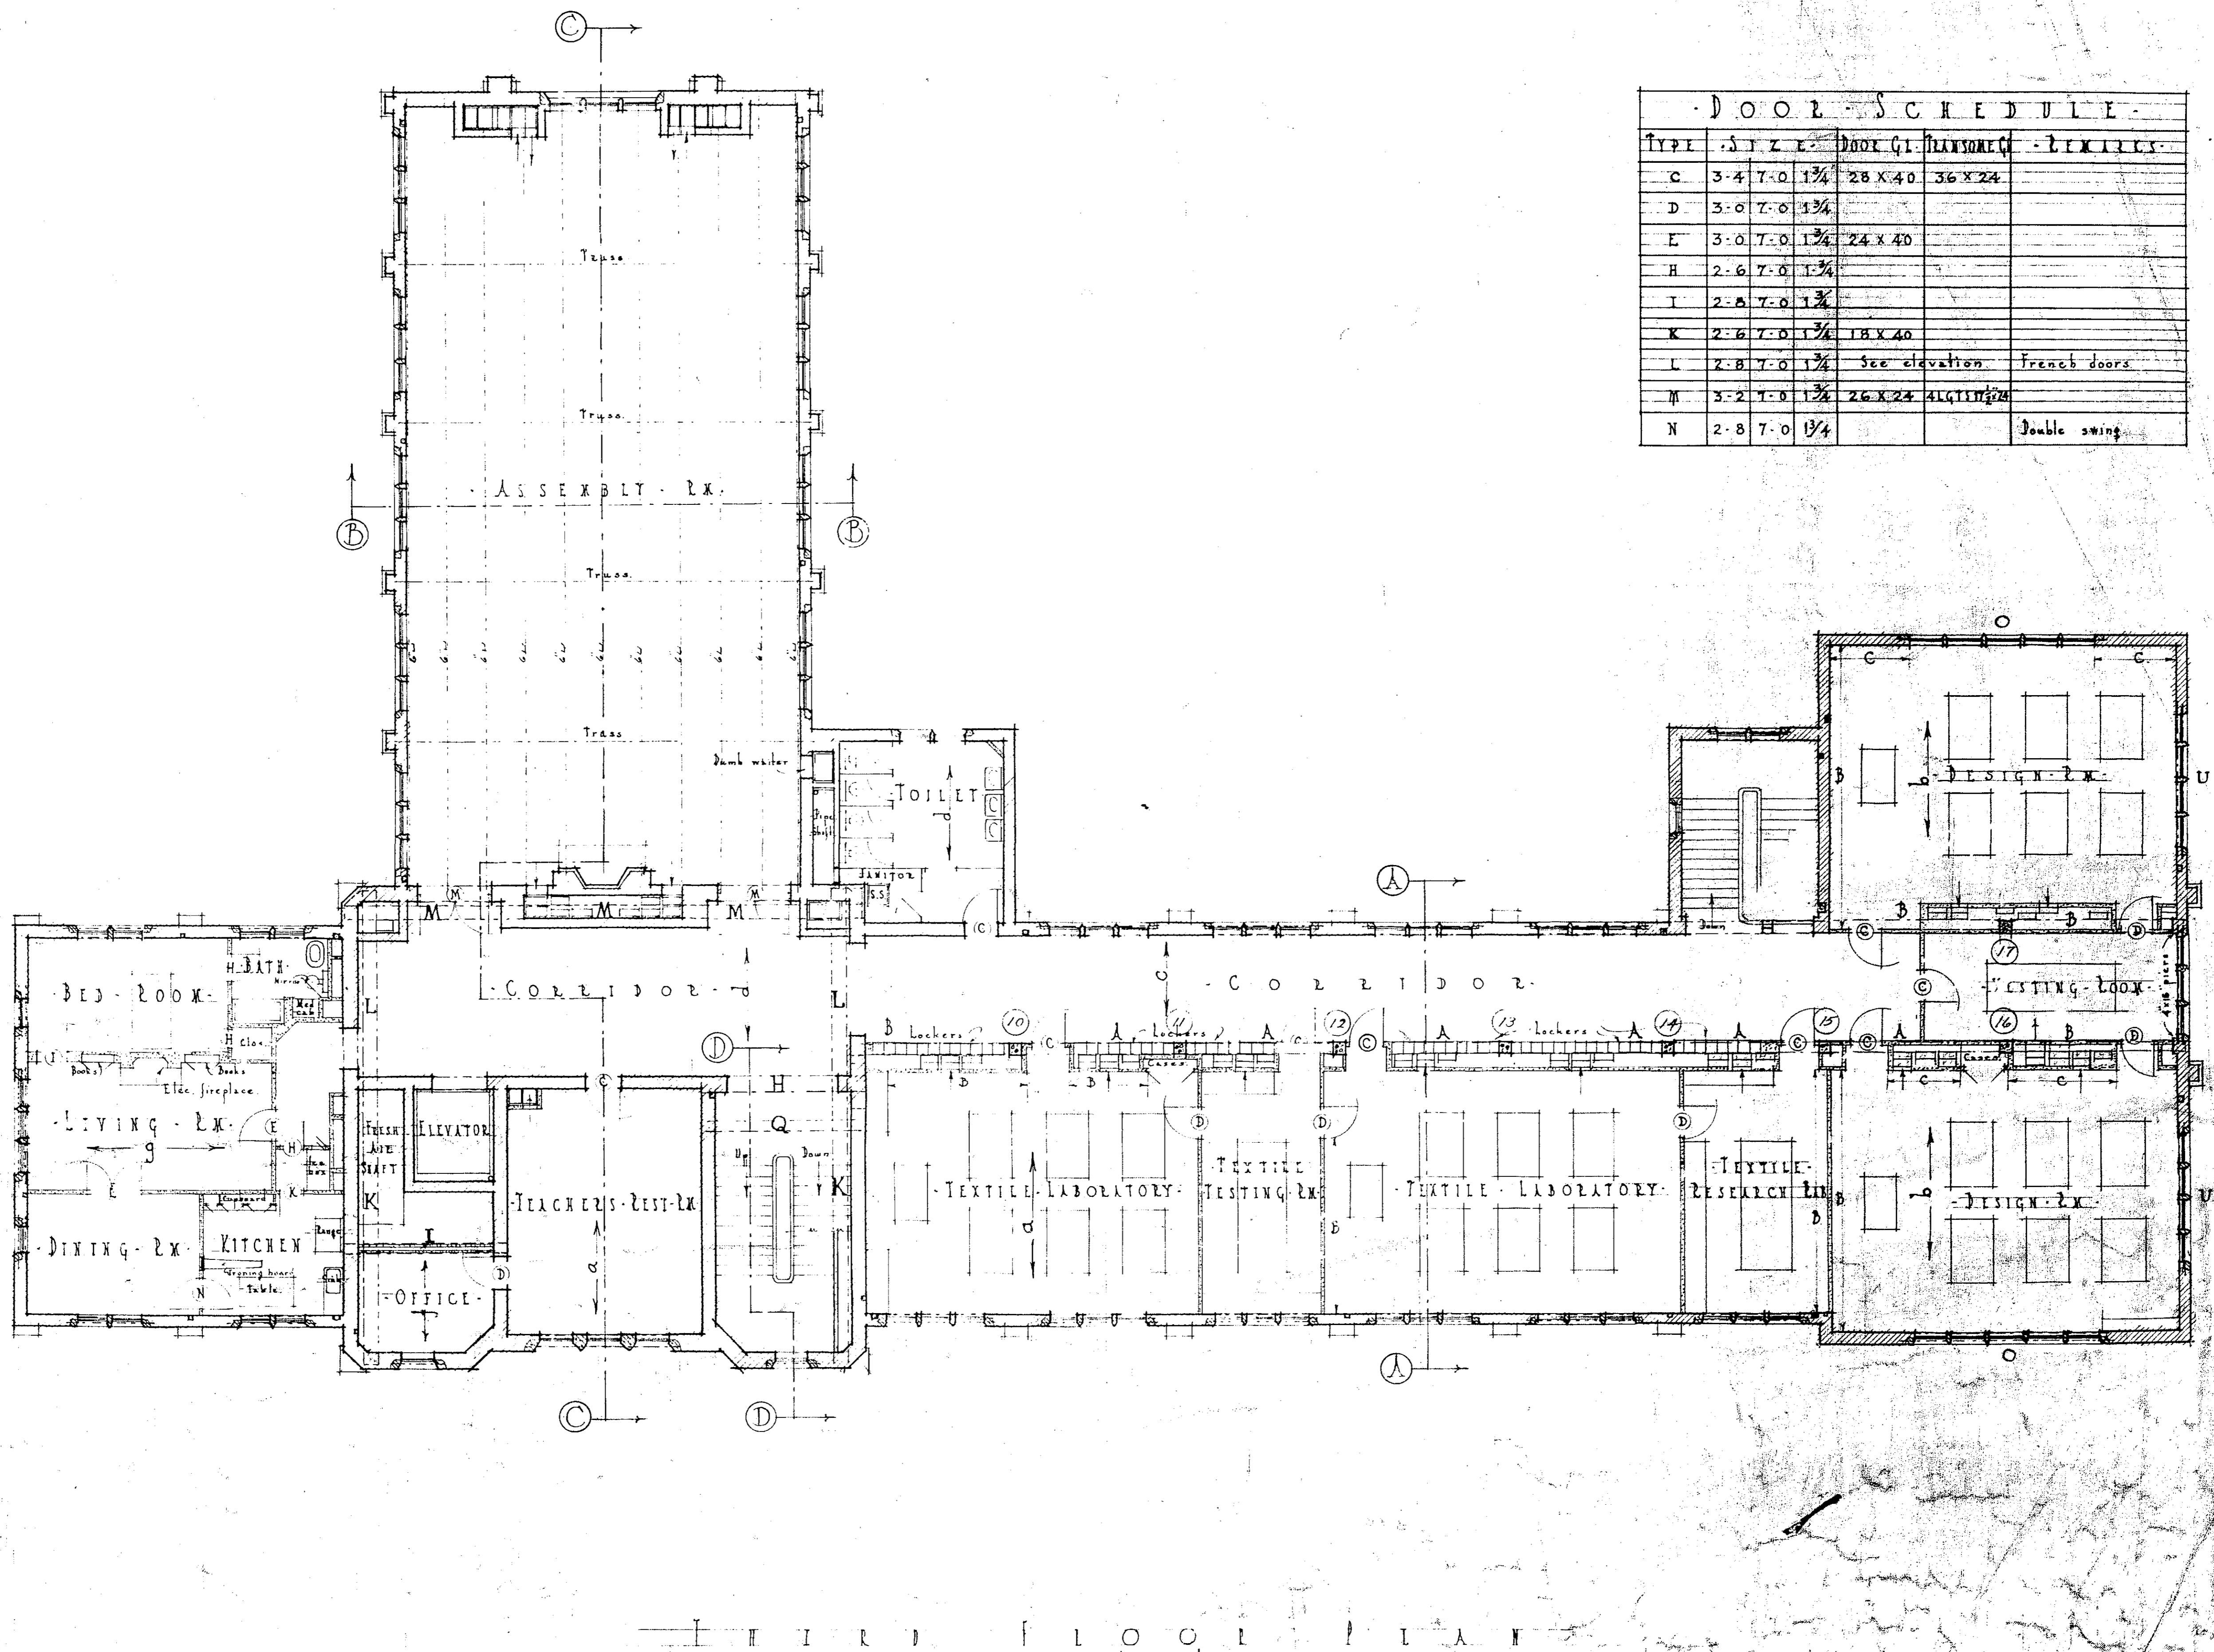

DOOR SCHEDULE						
TYPE	SIZE	DOOR	GLASS	FRAMING	MARKS	NOTES
C	3-4 7-0 1 ³ / ₄		28 x 40	36 x 24		
D	3-0 7-0 1 ³ / ₄					
E	3-0 7-0 1 ³ / ₄		24 x 40			
H	2-6 7-0 1 ³ / ₄					
I	2-8 7-0 1 ³ / ₄					
K	2-6 7-0 1 ³ / ₄		18 x 40			
L	2-8 7-0 1 ³ / ₄	See elevation			French doors	
M	3-2 7-0 1 ³ / ₄	26 x 24	4LG, 11 ¹ / ₂ x 24			
N	2-8 7-0 1 ³ / ₄				Double swing	


HOME ECONOMIC BUILDING
MICHIGAN AGRICULTURAL COLLEGE
EDWIN BOWD, A. R. C. H. REC'D., L. M. H. C. G.


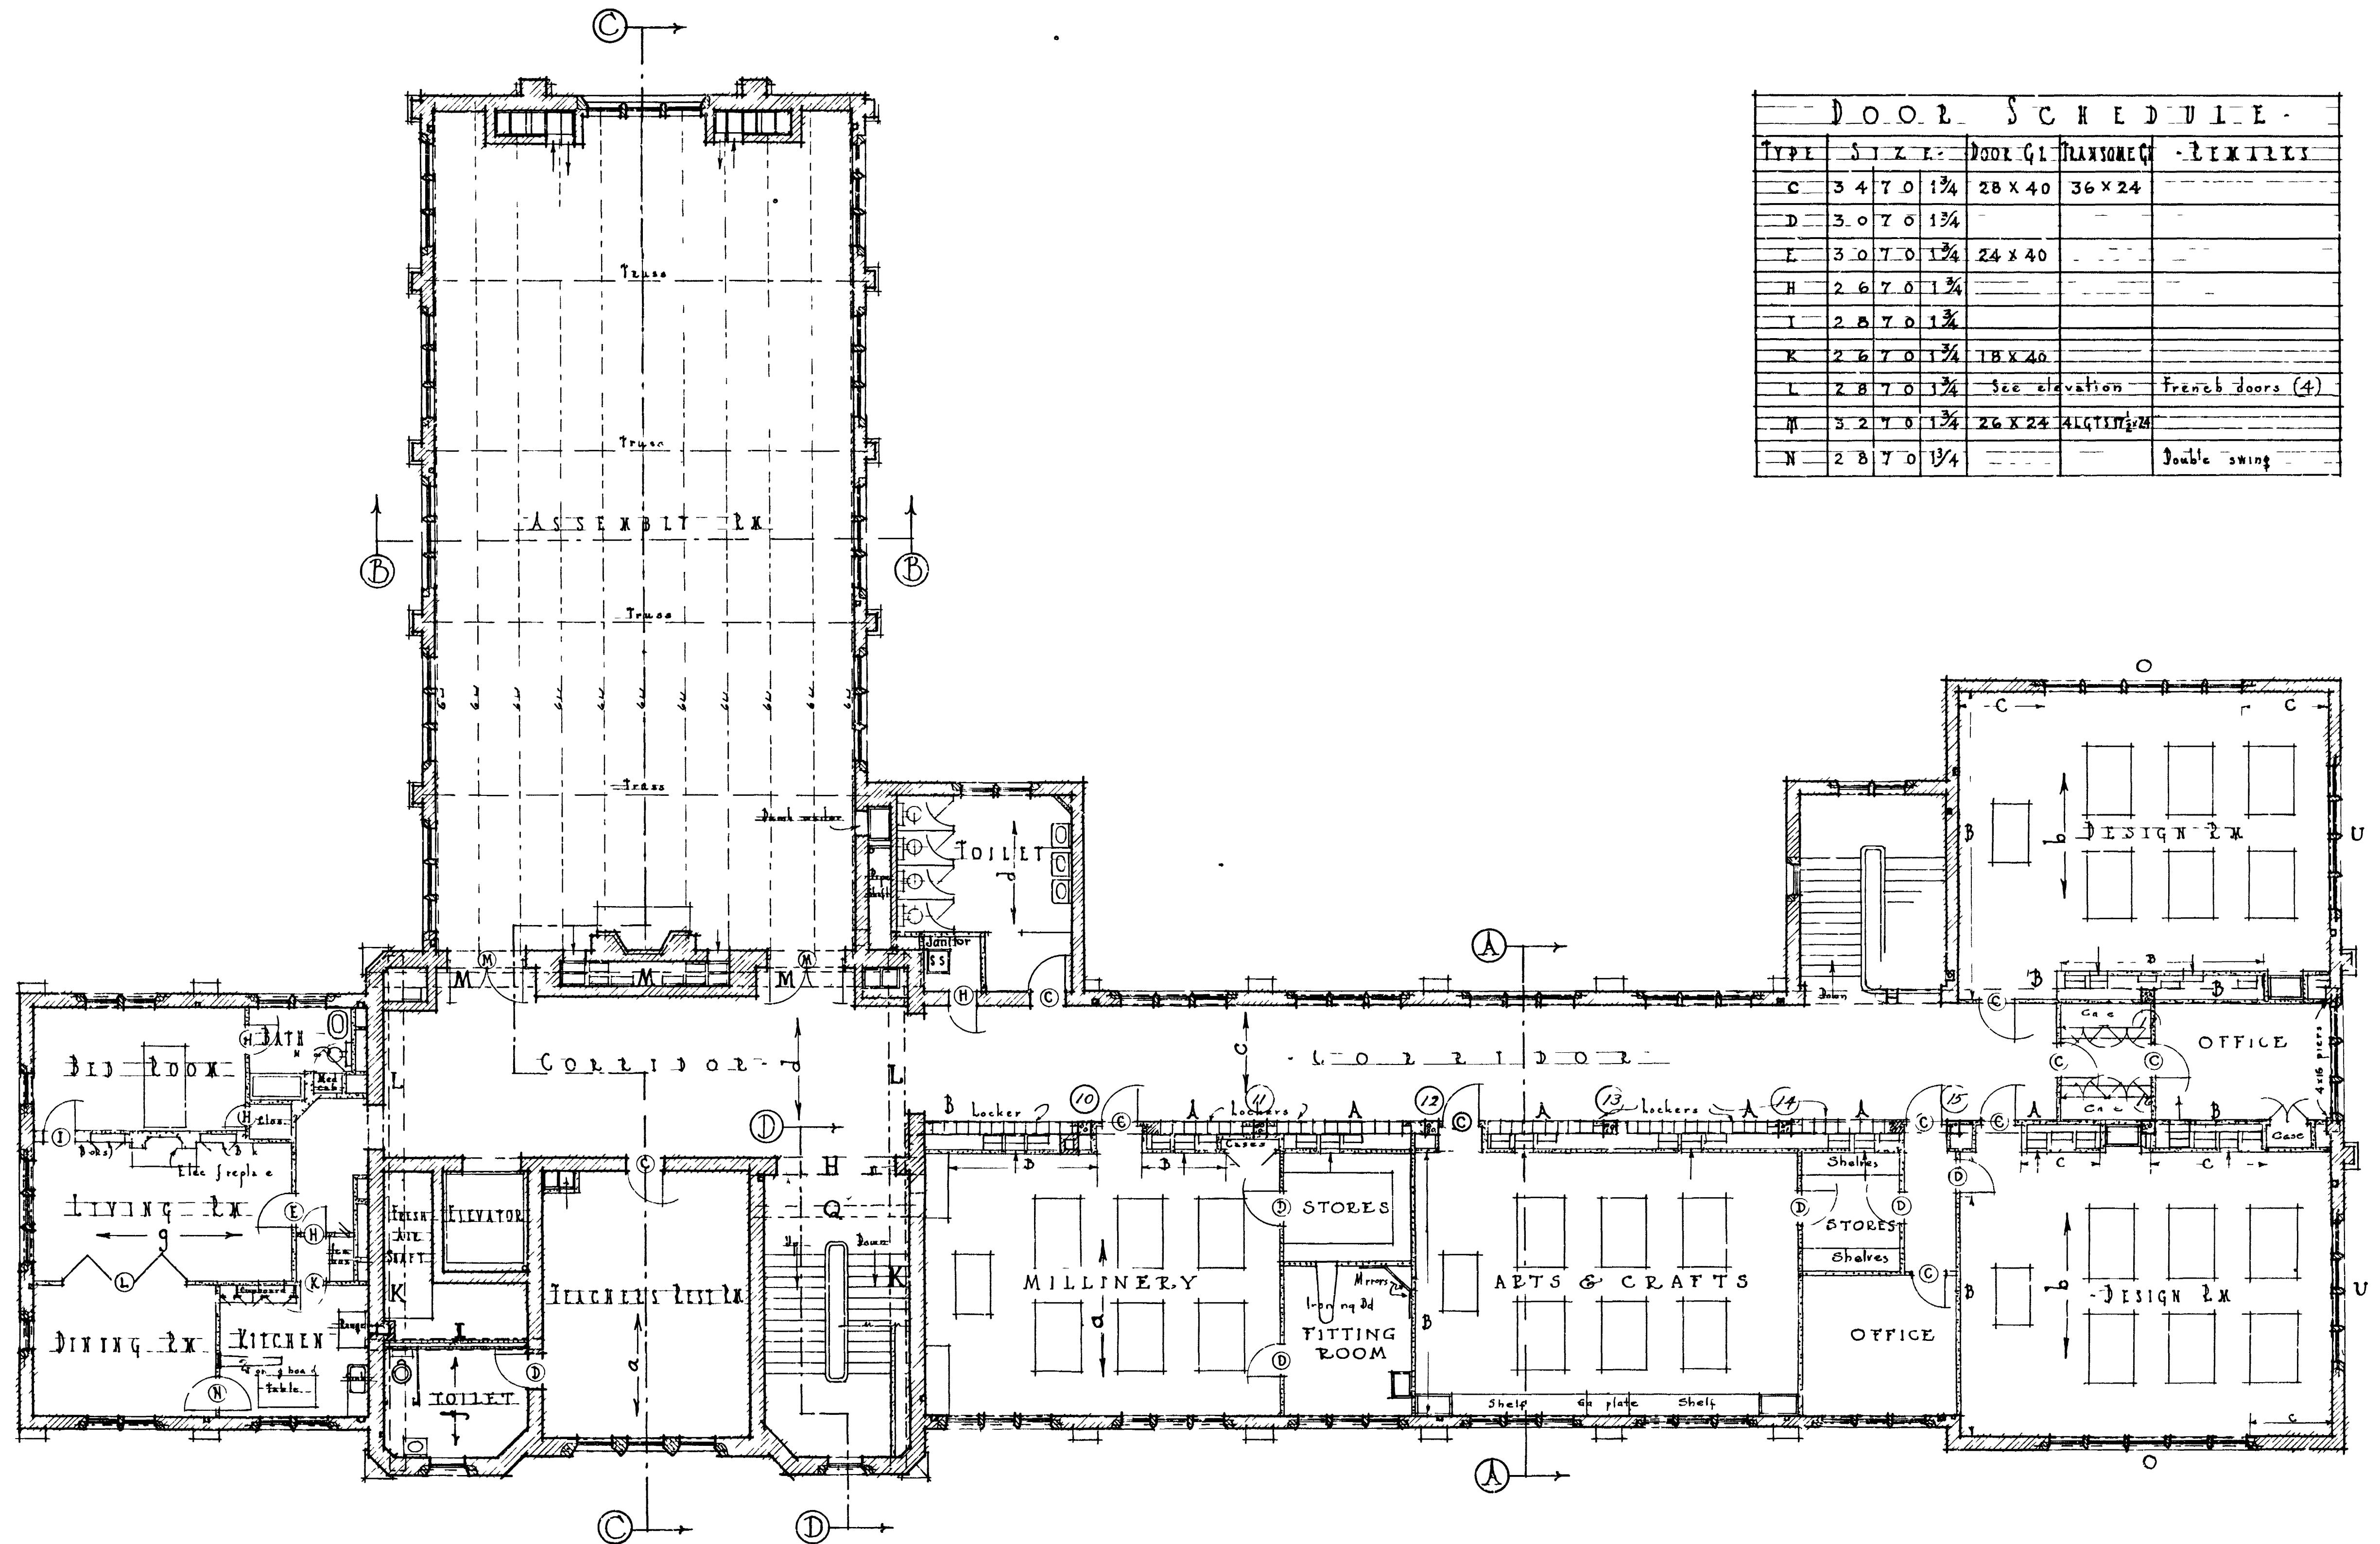


REVISED

1001
Scale 1/8" = 1'-0"

COLLEGE BUILDING
MICHIGAN STATE COLLEGE

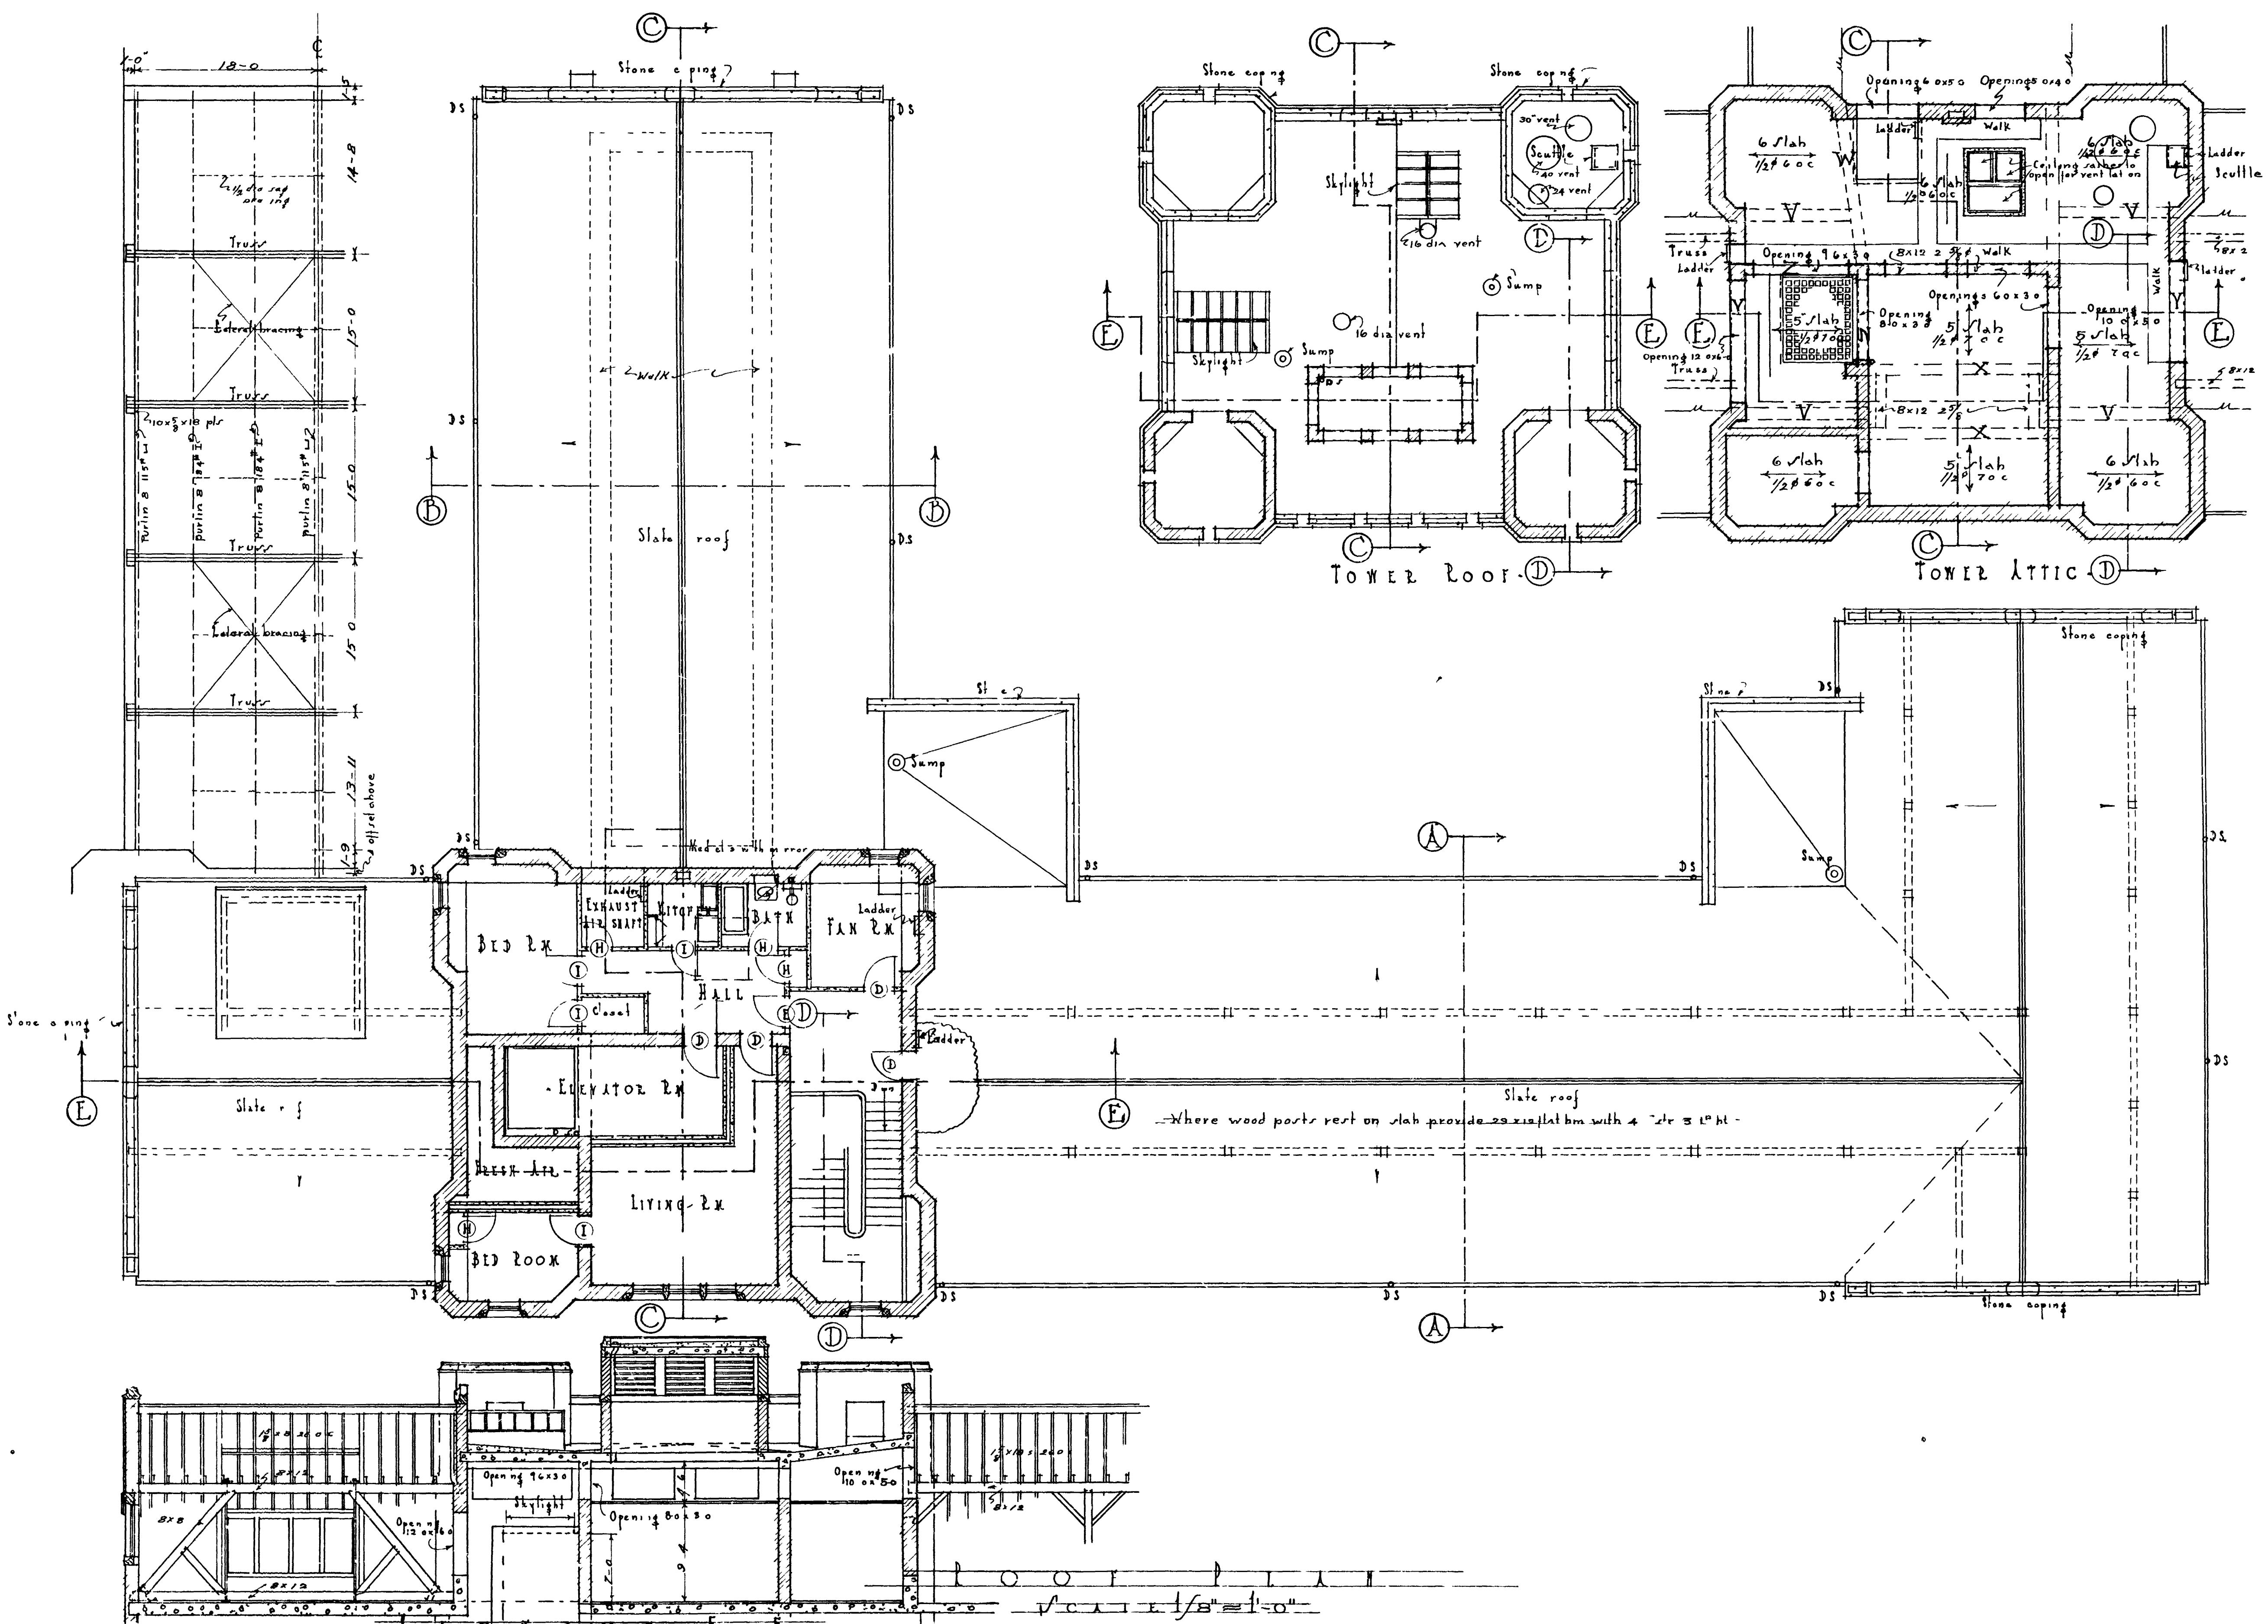


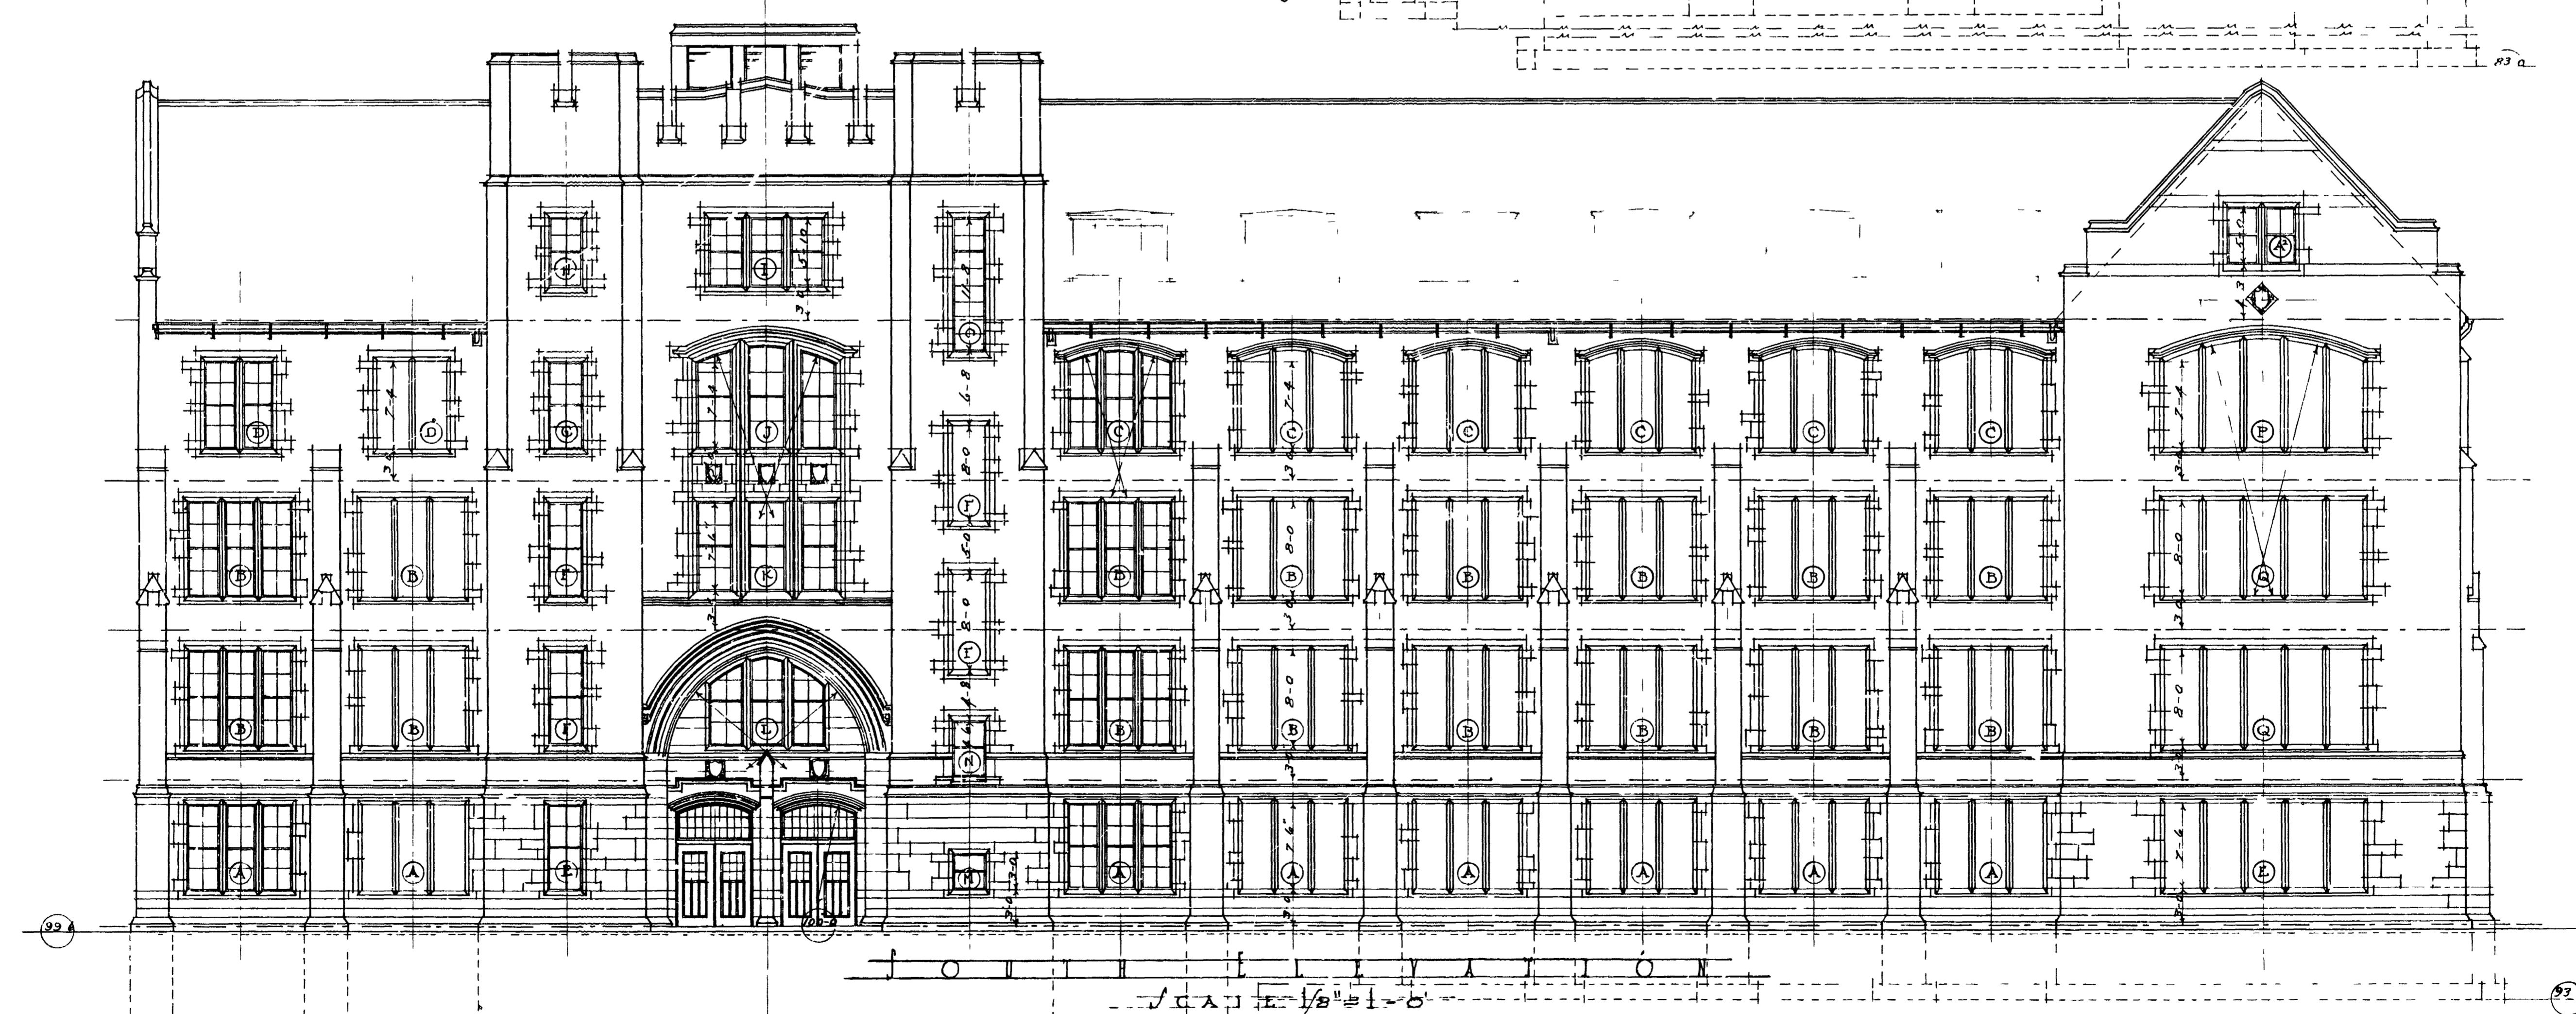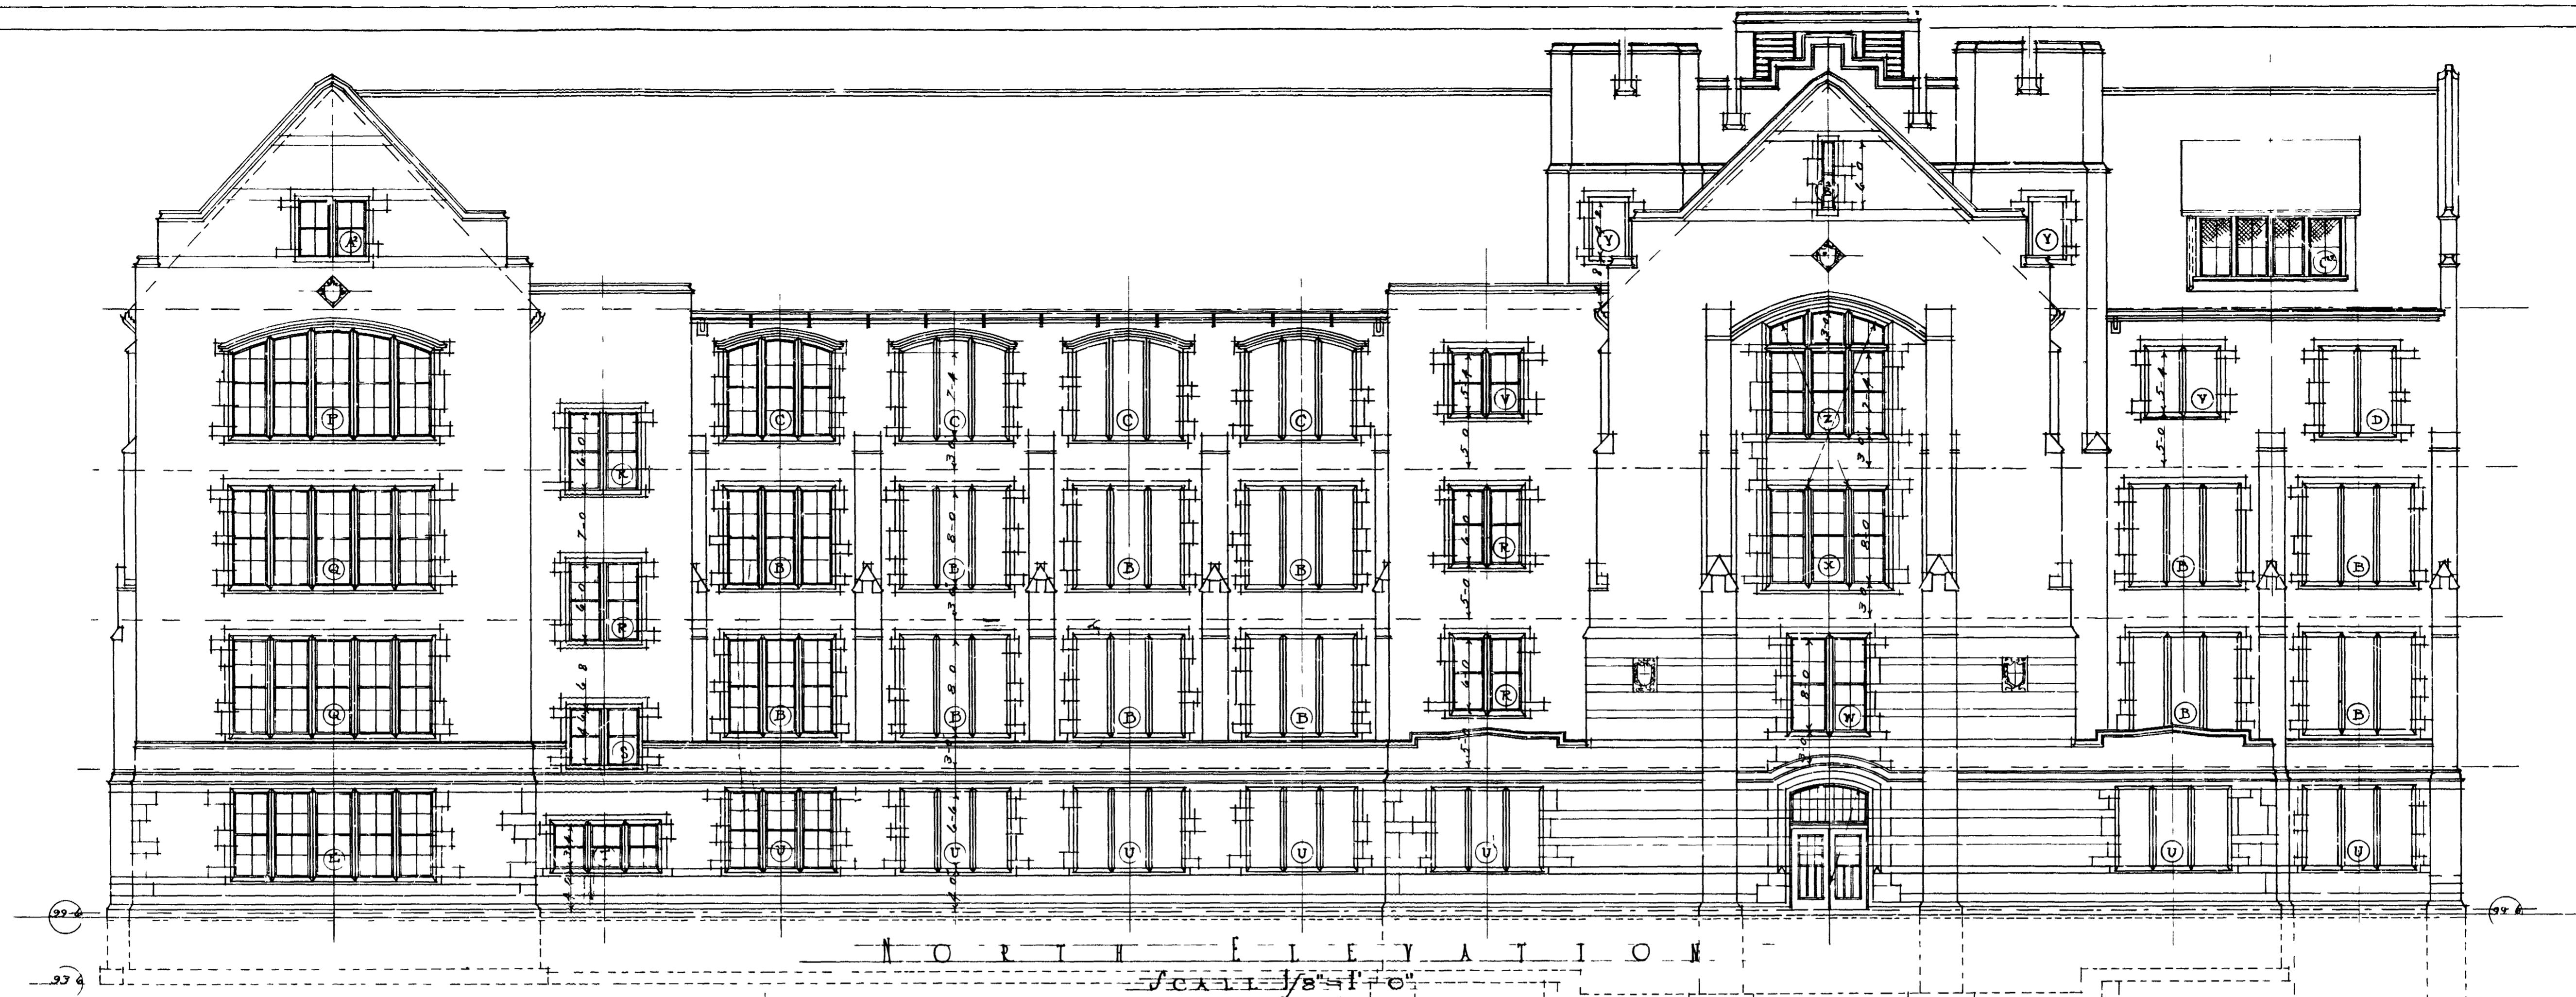


COLLEGE OF POLYTECHNIC BUILDING
EDWARDIAN COLLEGE, LONDON, ENGLAND

8

MICHIGAN AVENUE
FIRE INSURANCE
CONTRACT, 1916, MICHIGAN AVENUE

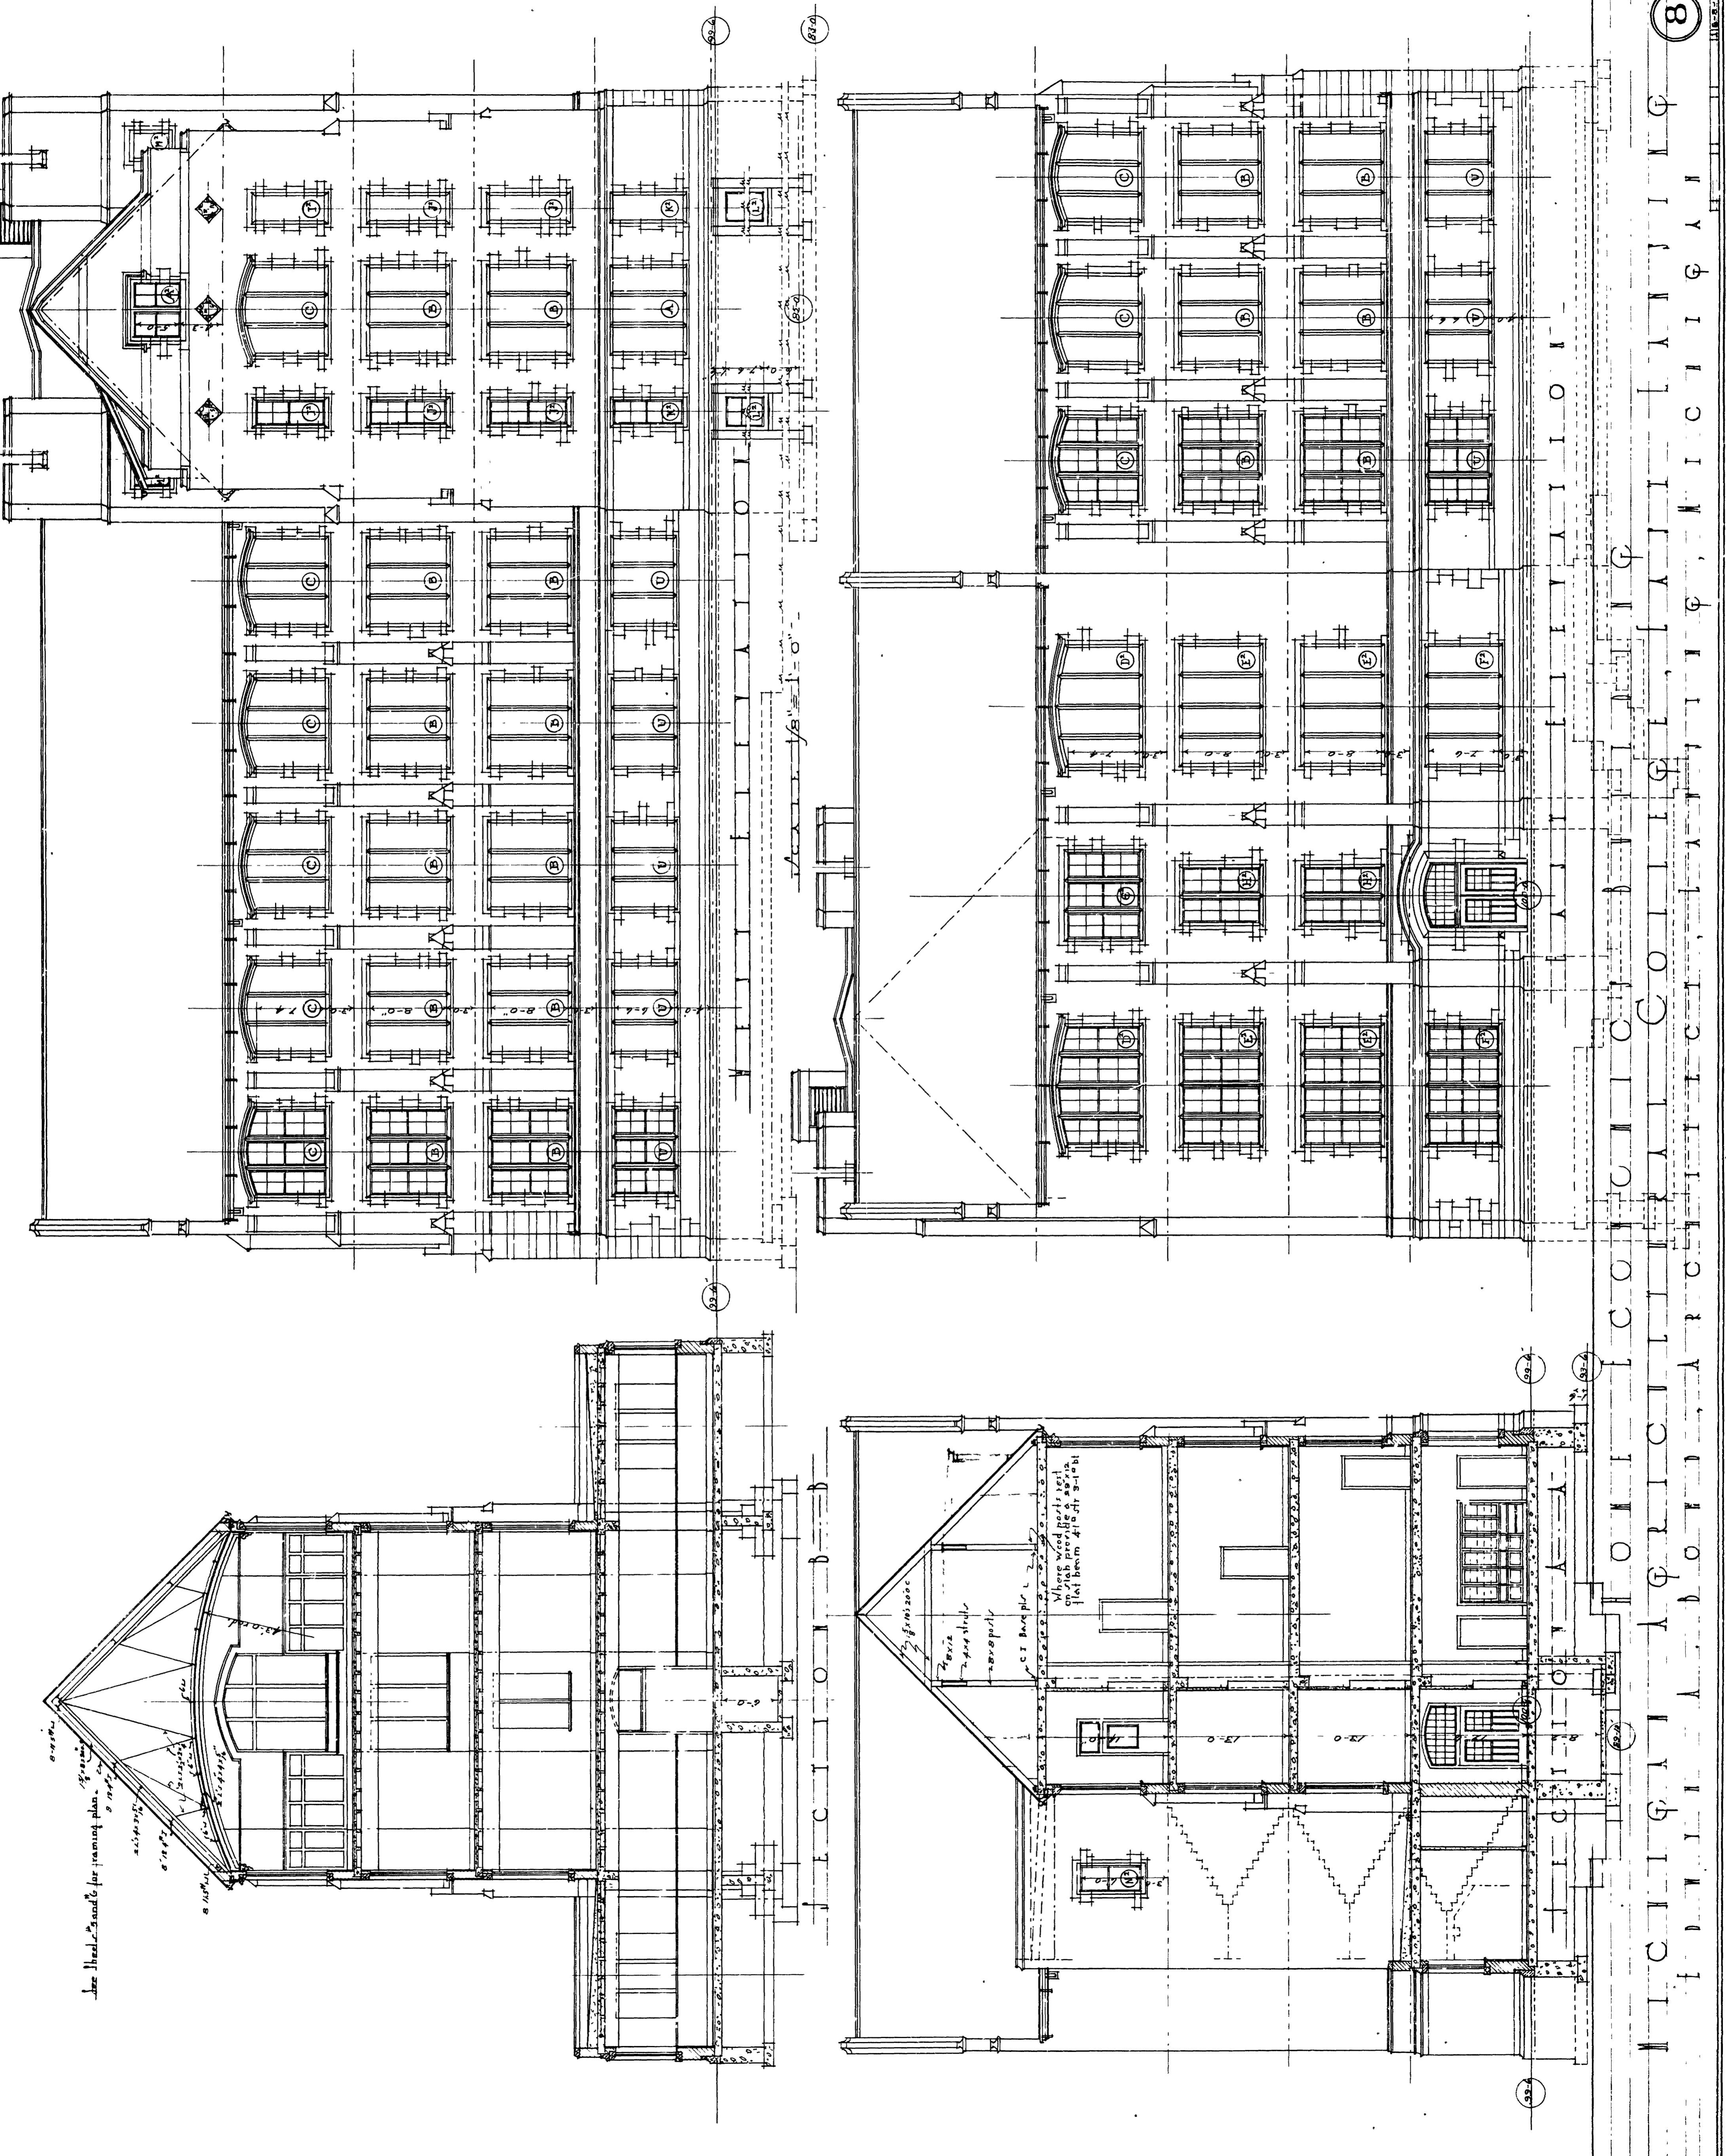

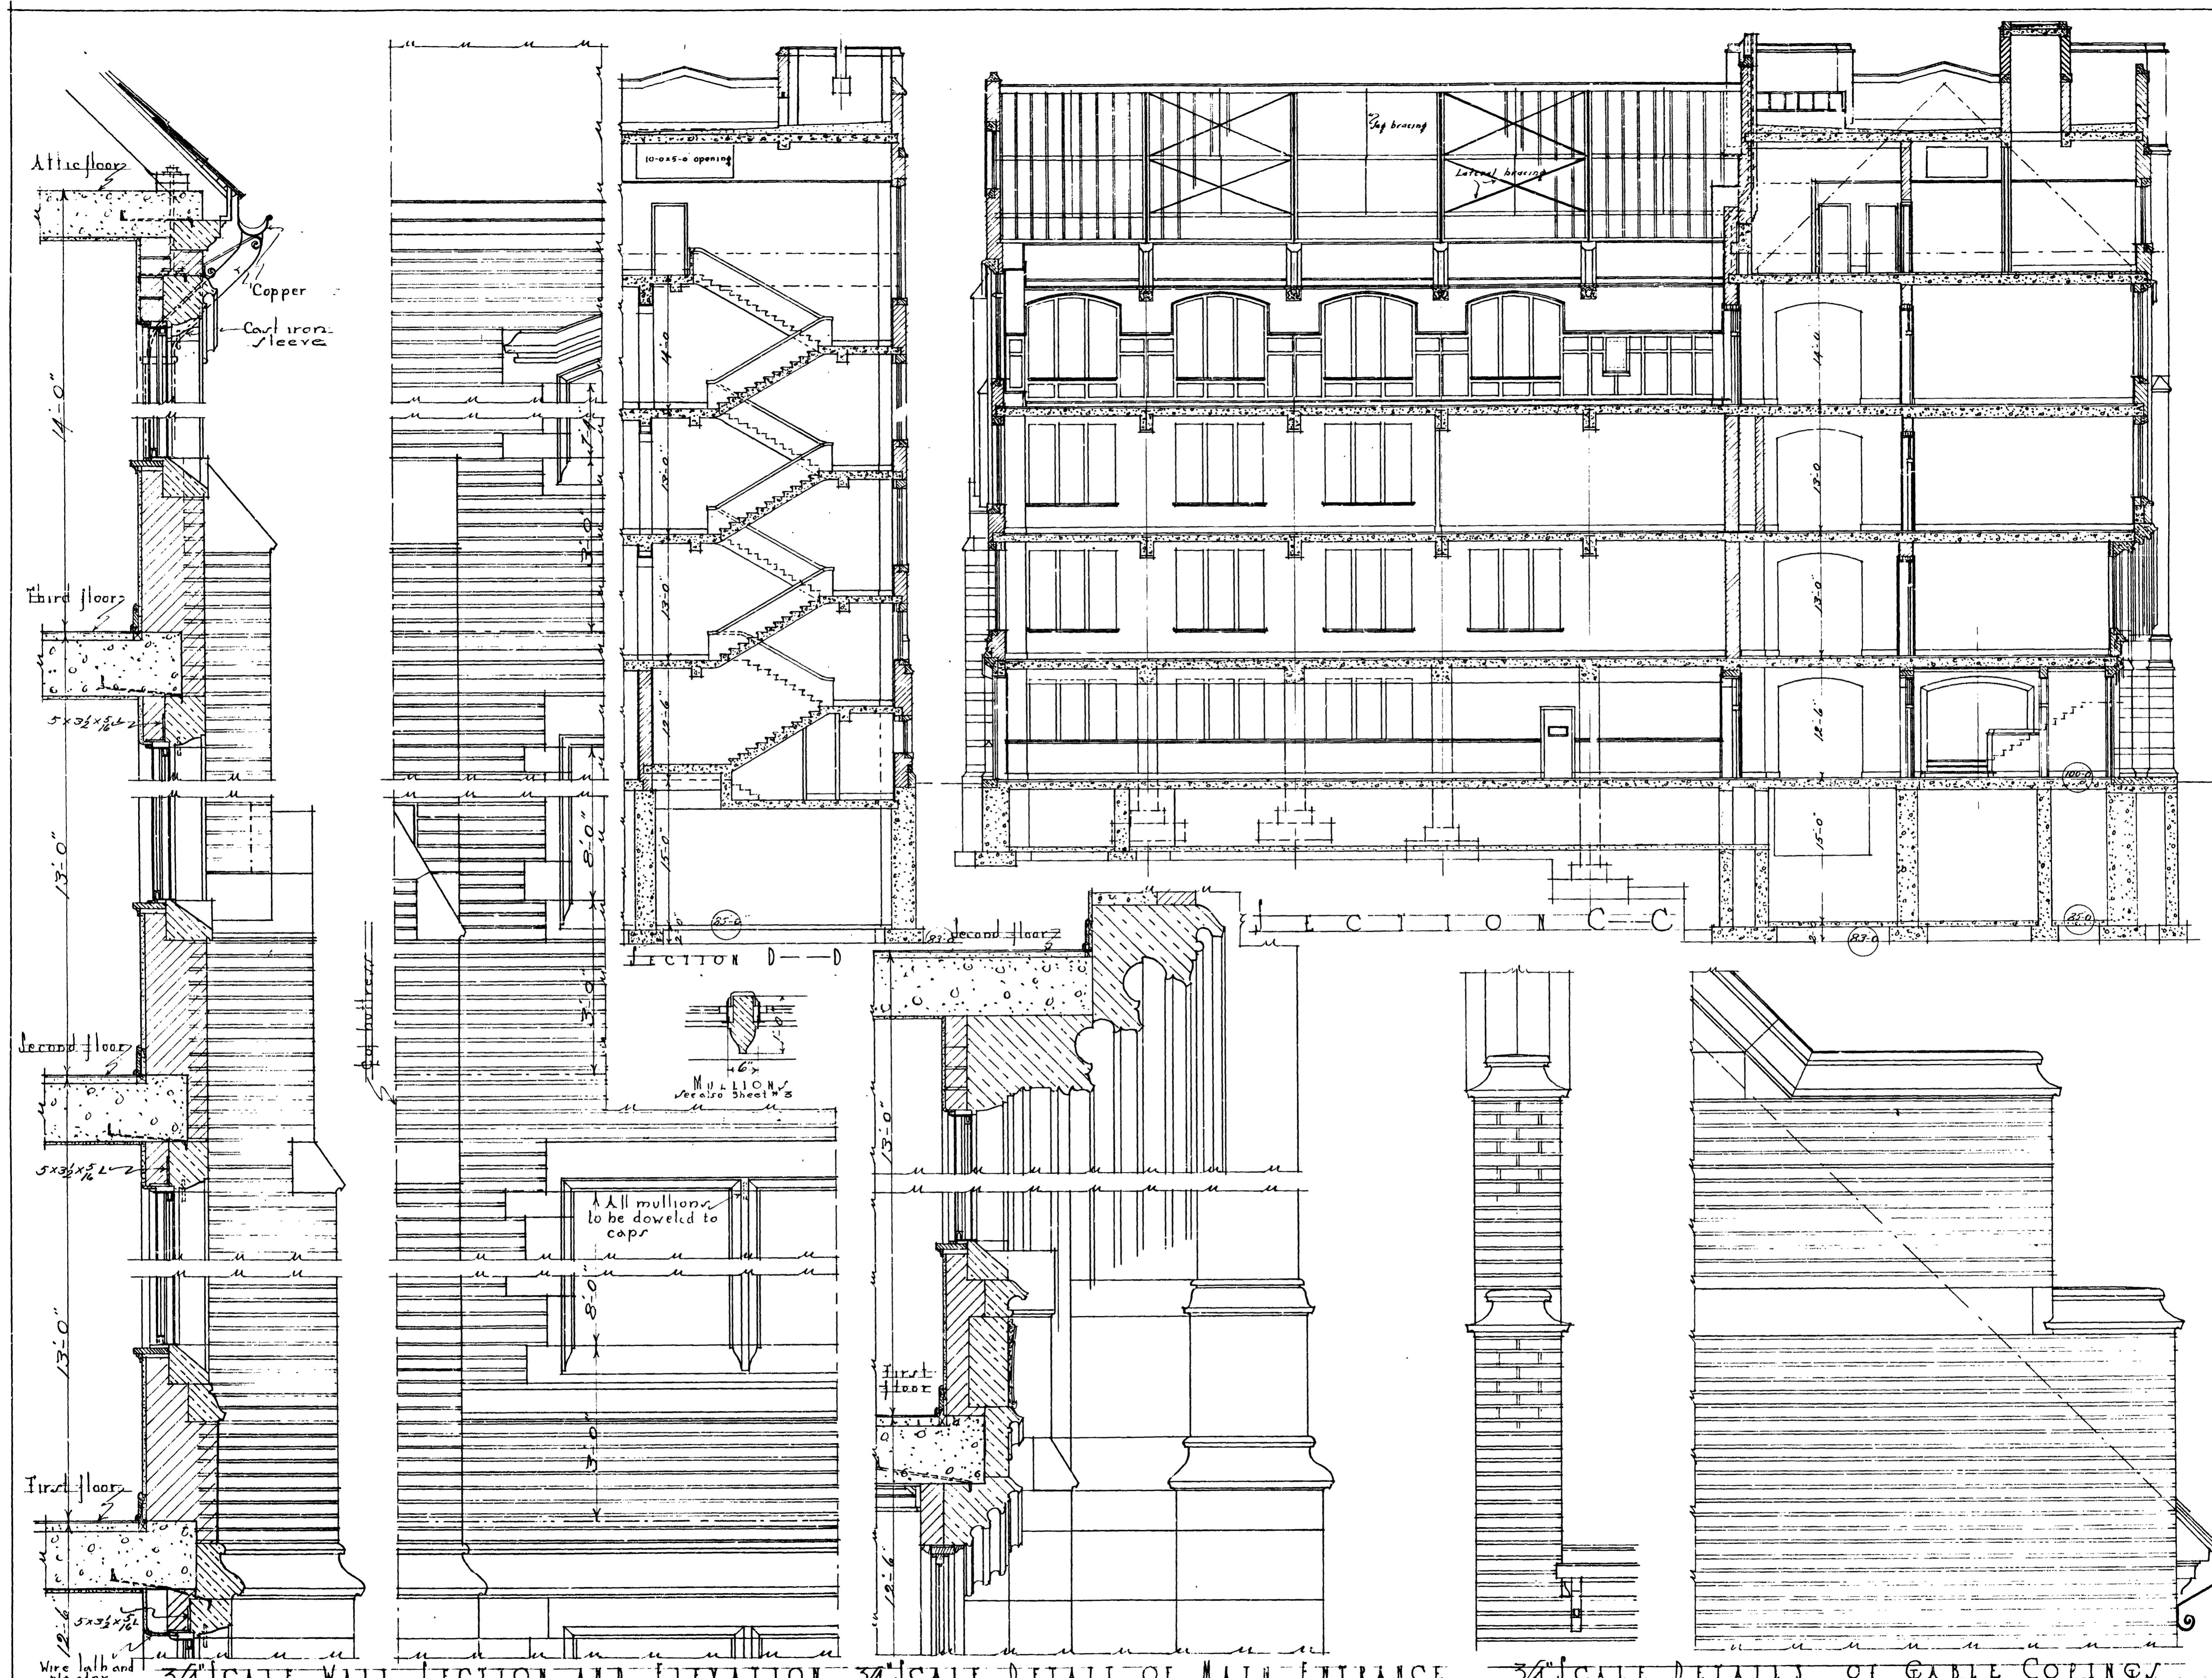

Wire lath and
plaster 3/4" STCATE WALL

SECTION AND ELEVATION

34 SCALE DETAIL OF MAIN ENTRANCE

3/4" SCALE DETAILS OF GABLE COPING

Home Economics

MICHIGAN STATE COLLEGE LIBRARIES

FLOOR SLAB DETAILS

5" except for slab g

18" c/c
at right w/ to joists


5 for slab g

SLAB SCHEDULE


Mark	Slab Thickness	Reinforcement			Remarks
		Straight	Bent	Stirrups	
a	10 + 2"	1-1" ϕ	1- $\frac{7}{8}$ " ϕ	$\frac{1}{4}$ ϕ @ 12" at ends	Use cantilever type at corridor end
b	12 + 2"	1-1" ϕ	1- $\frac{7}{8}$ " ϕ	$\frac{1}{4}$ ϕ @ 12" at ends	Use cantilever type at corridor end
c	4 + 2"	1- $\frac{3}{4}$ " ϕ	1- $\frac{1}{2}$ " ϕ	None	Use cantilever type
d	8 + 2"	1- $\frac{7}{8}$ " ϕ	1- $\frac{1}{2}$ " ϕ	None	Use cantilever type
e	6 + 2"	1- $\frac{3}{4}$ " ϕ	1- $\frac{1}{2}$ " ϕ	None	Cantilever type
g	12 + 3"	1- $\frac{1}{8}$ " ϕ	1-1" ϕ	$\frac{1}{4}$ ϕ @ 12" at ends	Use cantilever type both ends take joists 5"
f	6 + 2"	1- $\frac{3}{4}$ " ϕ	1- $\frac{5}{8}$ " ϕ	None	Cantilever type

Extend bars from C to centre of D.

Lintels for windows 8x12 with $2\frac{5}{8}$ str. and $2\frac{1}{2}$ bent, except
Windows marked O and U on Plans, which are given in Bm. Schedule.

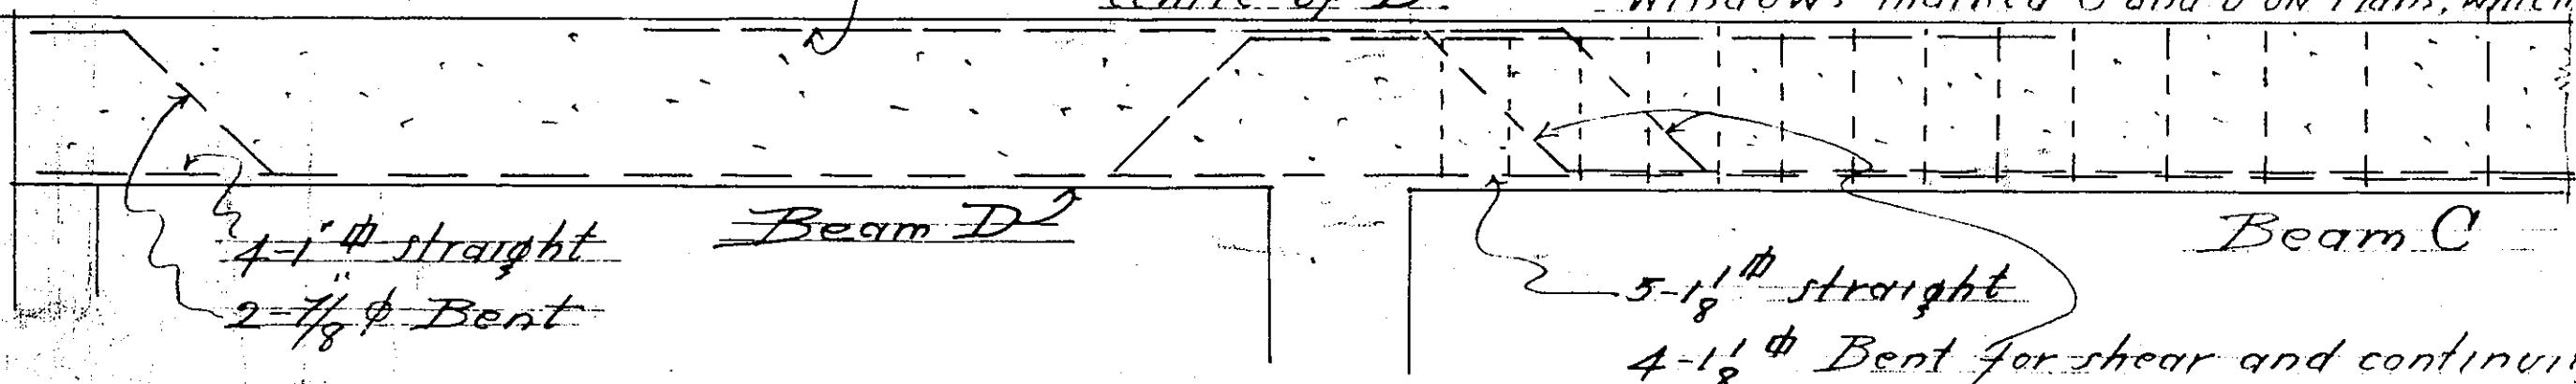

DETAIL BEAMS C AND D

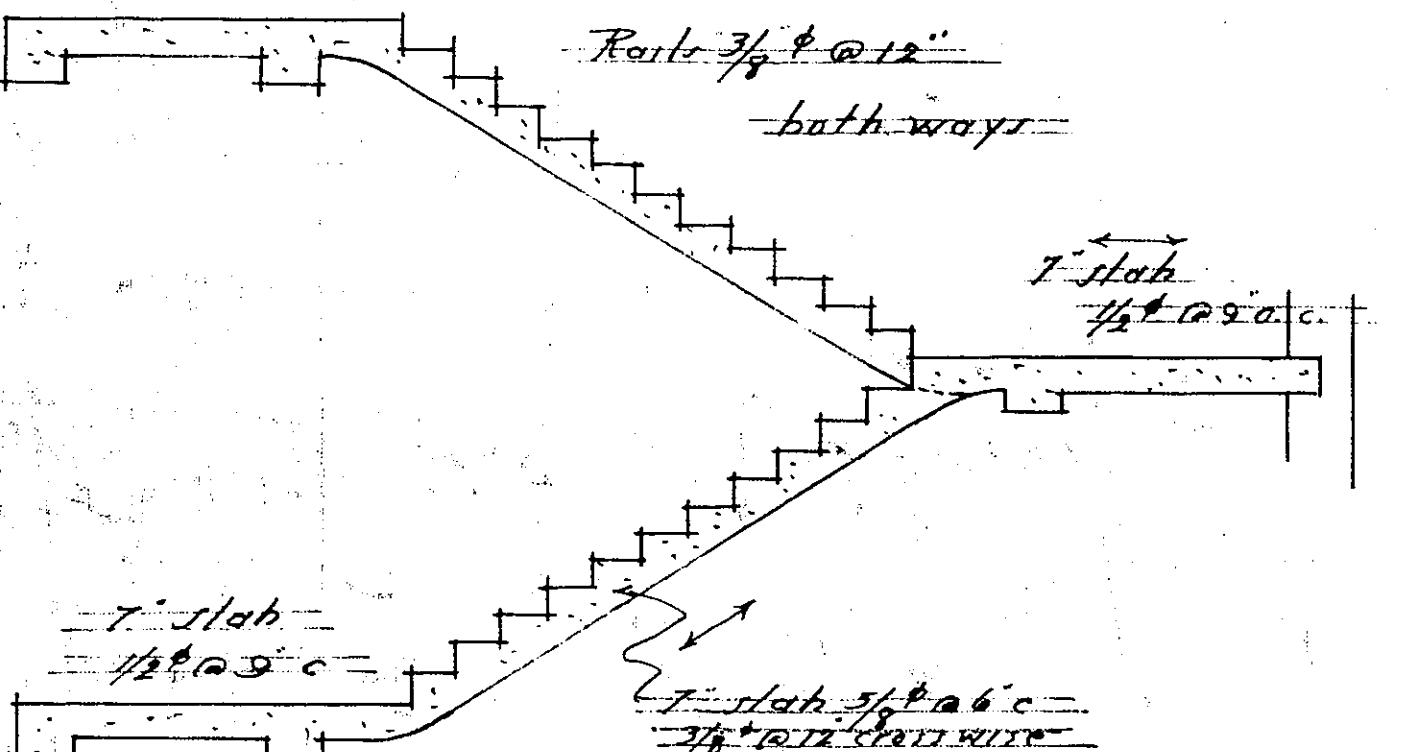

Typical Hair Details

BEAM SCHEDULE

Beam	Size	Tee	Straight	Bent	Stirrups	Remarks
P	25x24	None	3-1"φ	2-1"φ	None	Hook bent bars
Q	10x16	None	2-1/8"φ	2-3/4"φ	3/8"φ @ 12"	
R	10x14	None	2-3/4"φ	2-5/8"φ	None	
S	10x14	None	1-5/8"φ	1-5/8"φ	None	
T	21x18	None	2-3/4"φ	2-3/4"φ	None	
U	8x18	5	2-5/8"φ	2-5/8"φ	None	
V	12x14	None	2-3/4"φ	2-5/8"φ	None	
W	14x18	None	2-1"φ	2-1"φ	3/8"φ @ 9"	Space stirrups throughout
X	12x20	None	2-1"φ	2-1"φ	3/8"φ @ 12"	
Z	10x14	None	2-1/2"φ	2-1/2"φ	None	
Y	12x18	5	2-3/4"φ	2-5/8"φ	None	
ZZ	12x24	None	2-1"φ	2-1"φ	1/2"φ 12" o.c.	
A	12x24	24"	2-1"φ	2-3/4"φ	None	Tee of beam to be on corridor side of beam
B	12x24	28"	2-1"φ	2-3/4"φ	None	
C	24x30	56"	5-1/8"φ	4-1"φ	1/2"φ @ 12 at ends 18" c. centre	All bent bars to extend to centre of adjacent span
D	24x30	None	4-1"φ	2-7/8"φ	None	
K	16x40	5	4-1 1/8"φ	4-1"φ	1/2"φ @ 12 o.c.	4-1"φ x 20-0' 10' span
L	16x36	5	4-1"φ	4-7/8"φ	3/8"φ @ 12 o.c.	
M	16x24	5	3-3/4"φ	2-5/8"φ	3/8"φ @ 12 o.c.	
O	8x36	5	2-7/8"φ	2-3/4"φ	None	
G	12x24	24"	2-1 1/8"φ	2-1"φ	None	
H	12x20	None	2-1"φ	2-5/8"φ	None	
I	12x16	None	2-3/4"φ	2-5/8"φ	None	



COLUMN SCHEDULE.

Supporting	1-2-3-4-5 6-7-8-9	-10-11-12-13 14-15-16-17	
Roof			
4 TH		12 x 12 4-5/8" ϕ	
3 RD		14 x 14 4-3/4" ϕ	
2 ND		18 x 18 6-3/4" ϕ	
1 ST	24 x 24 8-1" ϕ	20 x 20 8-7/8" ϕ	
Footing I	7-6" x 7-6" x 1-10 Cap 3-4 x 3-4 x 1-1	6-3" x 6-3" x 1-6 Cap 2-8 x 2-8 x 1-0	
	12-5/8" ϕ each way	10-5/8" ϕ each way	


All columns to have stays $\frac{1}{2}$ " @ 12" c
Bars to be topped 18"

Dowels same size as column bars and $3 = 0.10$

Note: Where wood posts rest on slab—
(see sheet #6) use 23x12 flat beam with
4-1⁴ str. and 3-1¹ ft.

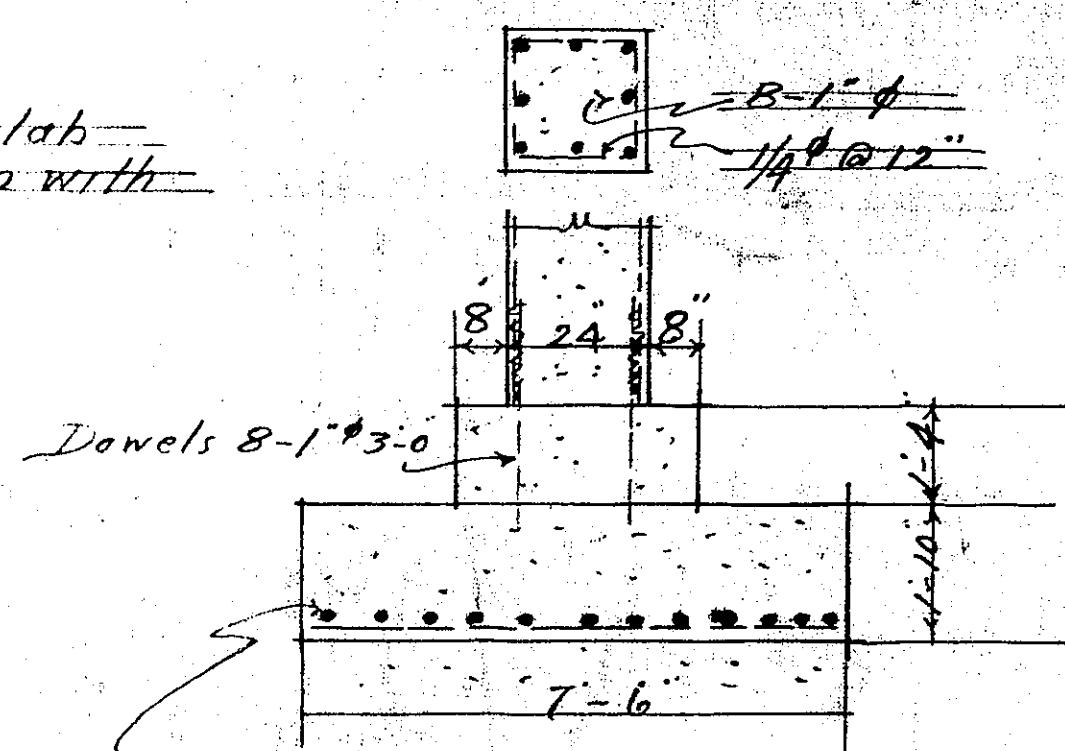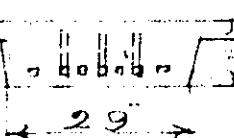

TOOING FOR COLUMNS 1.2.3.4.5.6.7.8.9

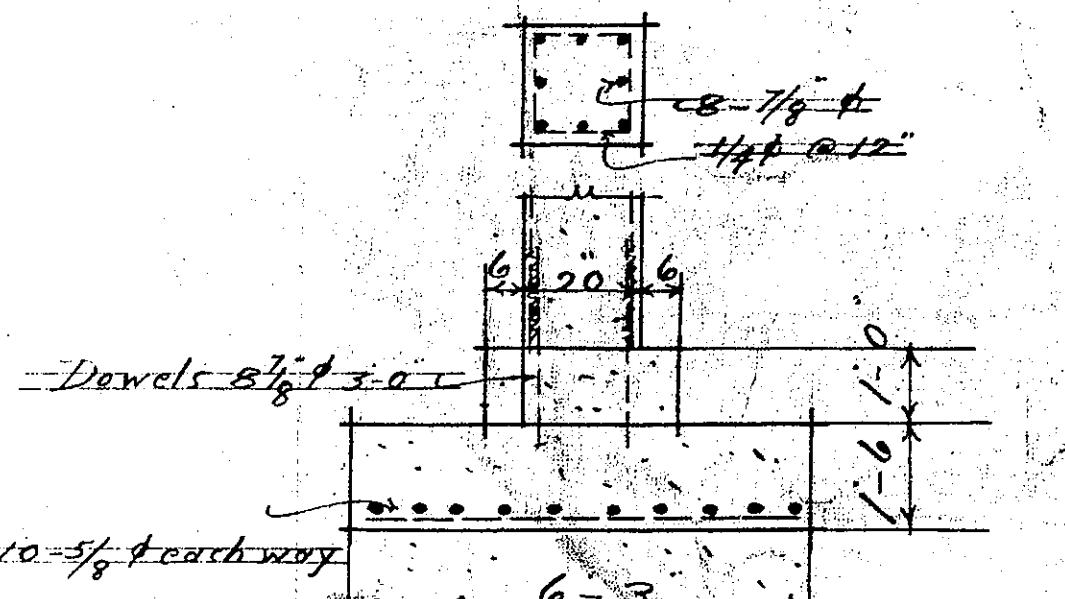

FOOTINGS FOR COLUMNS

REINFORCING — SCHEDEULE

H O M E F O C U S I N G I N G


MICHIGAN AGRICULTURAL COLLEGE EATING HABITS

KEY TO DRAINAGE.

S.P. SOIL PIPE.
 S.P.V. SOIL PIPE VENT.
 D.F.W. DRINKING FOUNTAIN WATER.
 D.F.V. VENT.
 S.W. SINK WASTE.
 S.V. SINK VENT.
 R.F.W. REFRIGERATOR WASTE.
 W.C. WATER CLOSET.
 L.A.Y. LAVATORY.
 L.W. LAVATORY WASTE.
 L.V. LAVATORY VENT.
 E.W.C. EAIN WATER CONDUCTOR.
 B.T. BELL TRAP.
 F.D. FLOOR DRAIN.
 C.O. CLEAN OUT.
 S.S. SLOP SINK.
 C.W. COLD WATER.
 H.W. HOT WATER.
 R.W. RETURN WATER.
 COND. CONDUCTOR.
 DRAINAGE.
 SANITARY.
 D.F.W. AND R.F.W.
 H.C. HOSE CONNECTION.

Present 6" water main.

Connect to present 6" water main approx. 50'-0" from building well.

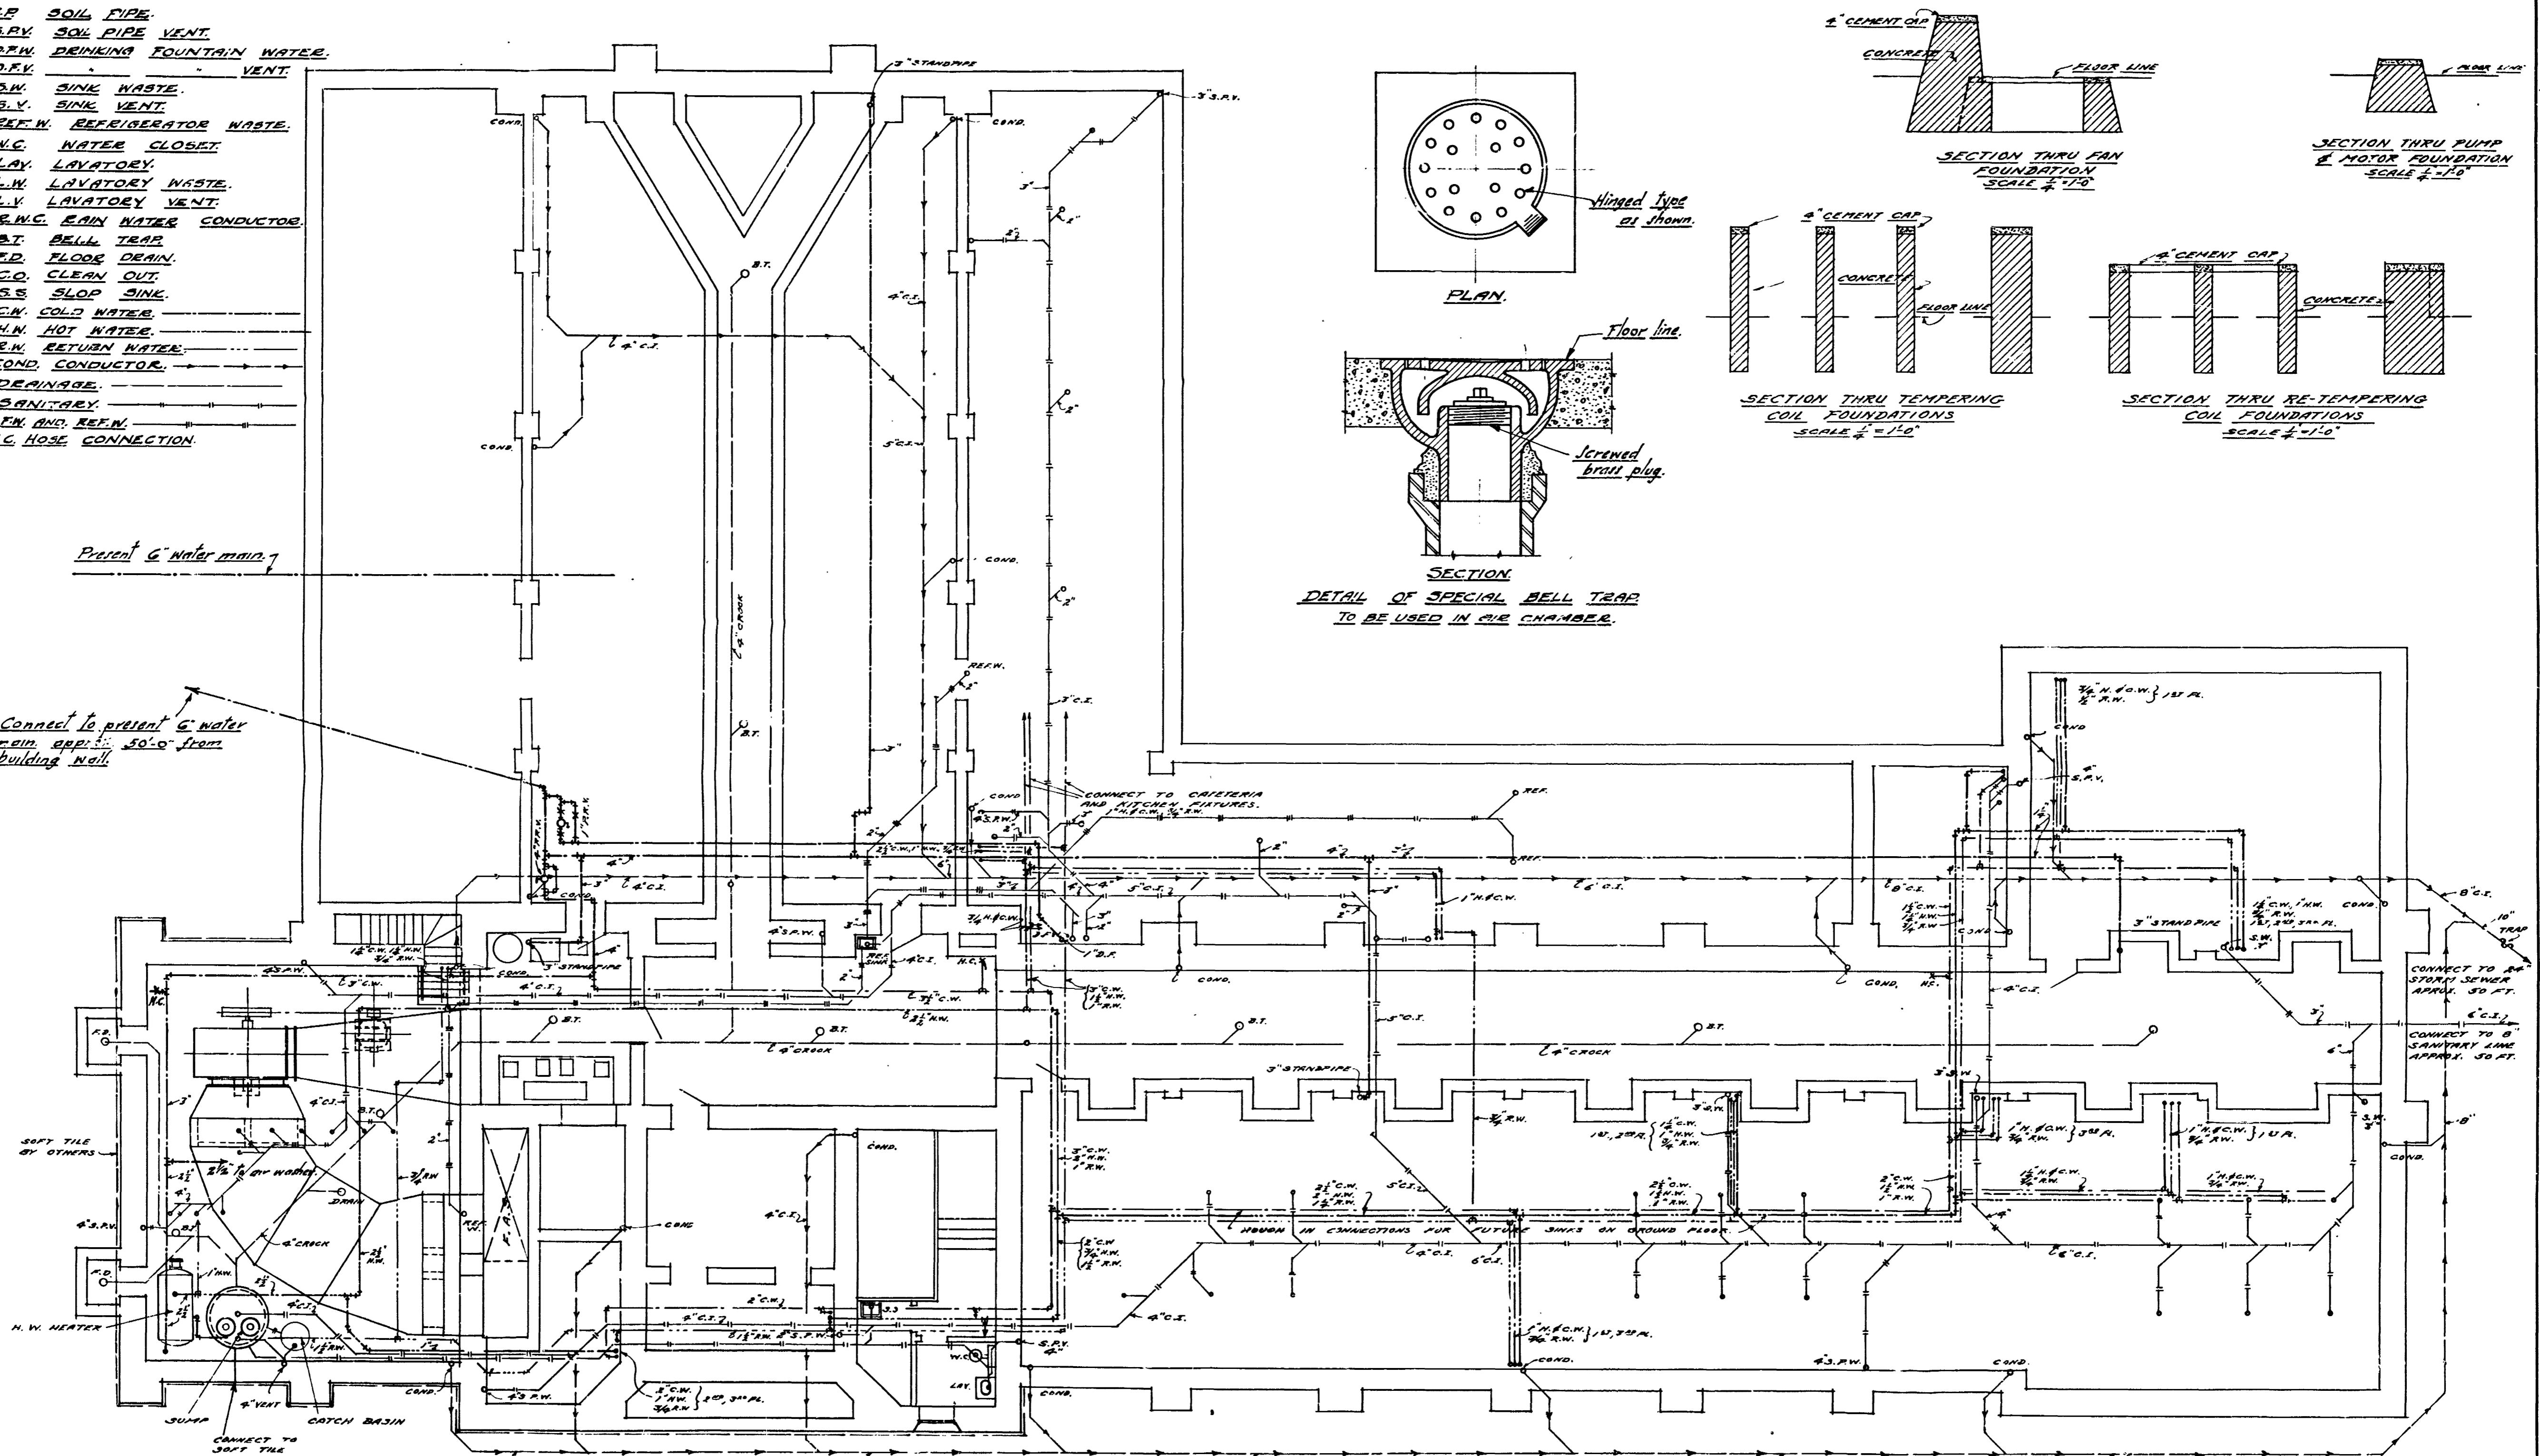

DRAINAGE PLAN.


SCALE $1/8 = 1:0$.

13-17-72

EDWYN A. BOND.
ARCHITECT.
LANSING, MICHIGAN.

SERVICE EQUIPMENT
HOME ECONOMICS BUILDING,
MICHIGAN AGRICULTURAL COLLEGE, DATE
APPROVED BY *Gov. Diesel* M.E. 6-23-22

1A

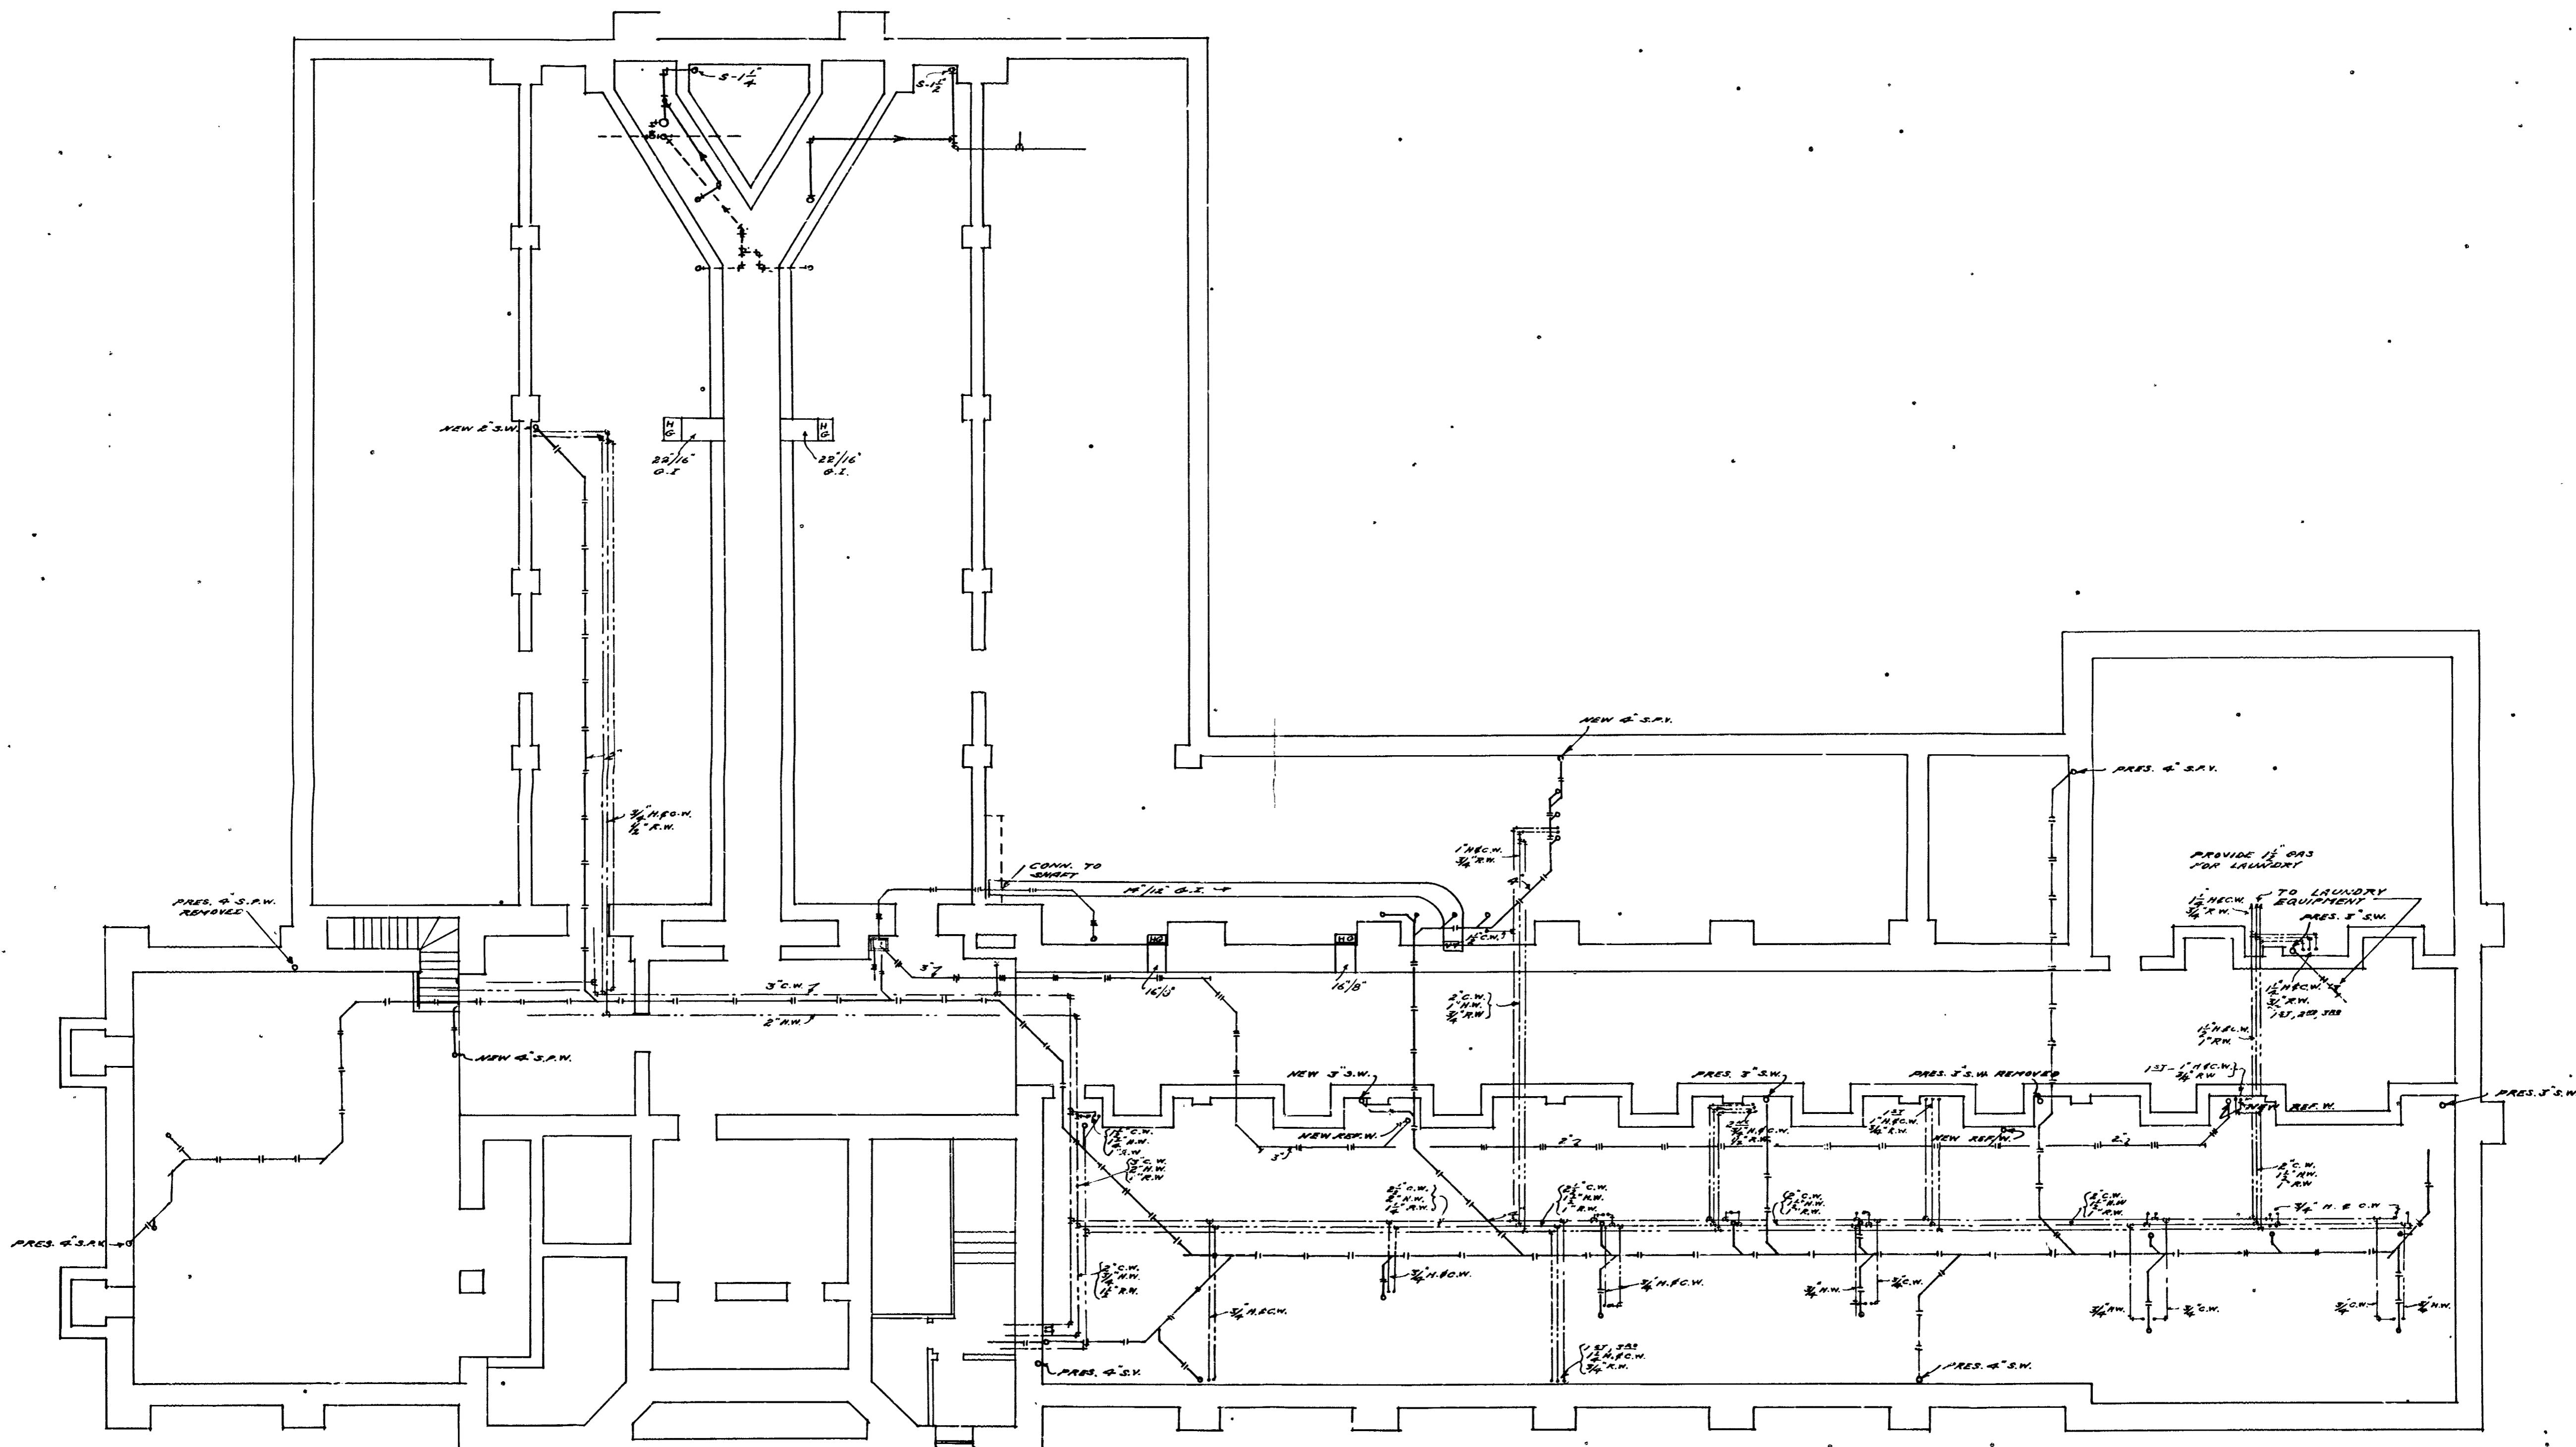


REVISED DRAINAGE PLAN
SCALE 1/8" = 1'-0"

3-17-7a

EDWYN A. BOWD
ARCHITECT
LANSING MICHIGAN

SERVICE EQUIPMENT
HOME ECONOMICS BUILDING
MICHIGAN AGRICULTURAL COLLEGE
APPROVED BY

1
DATE

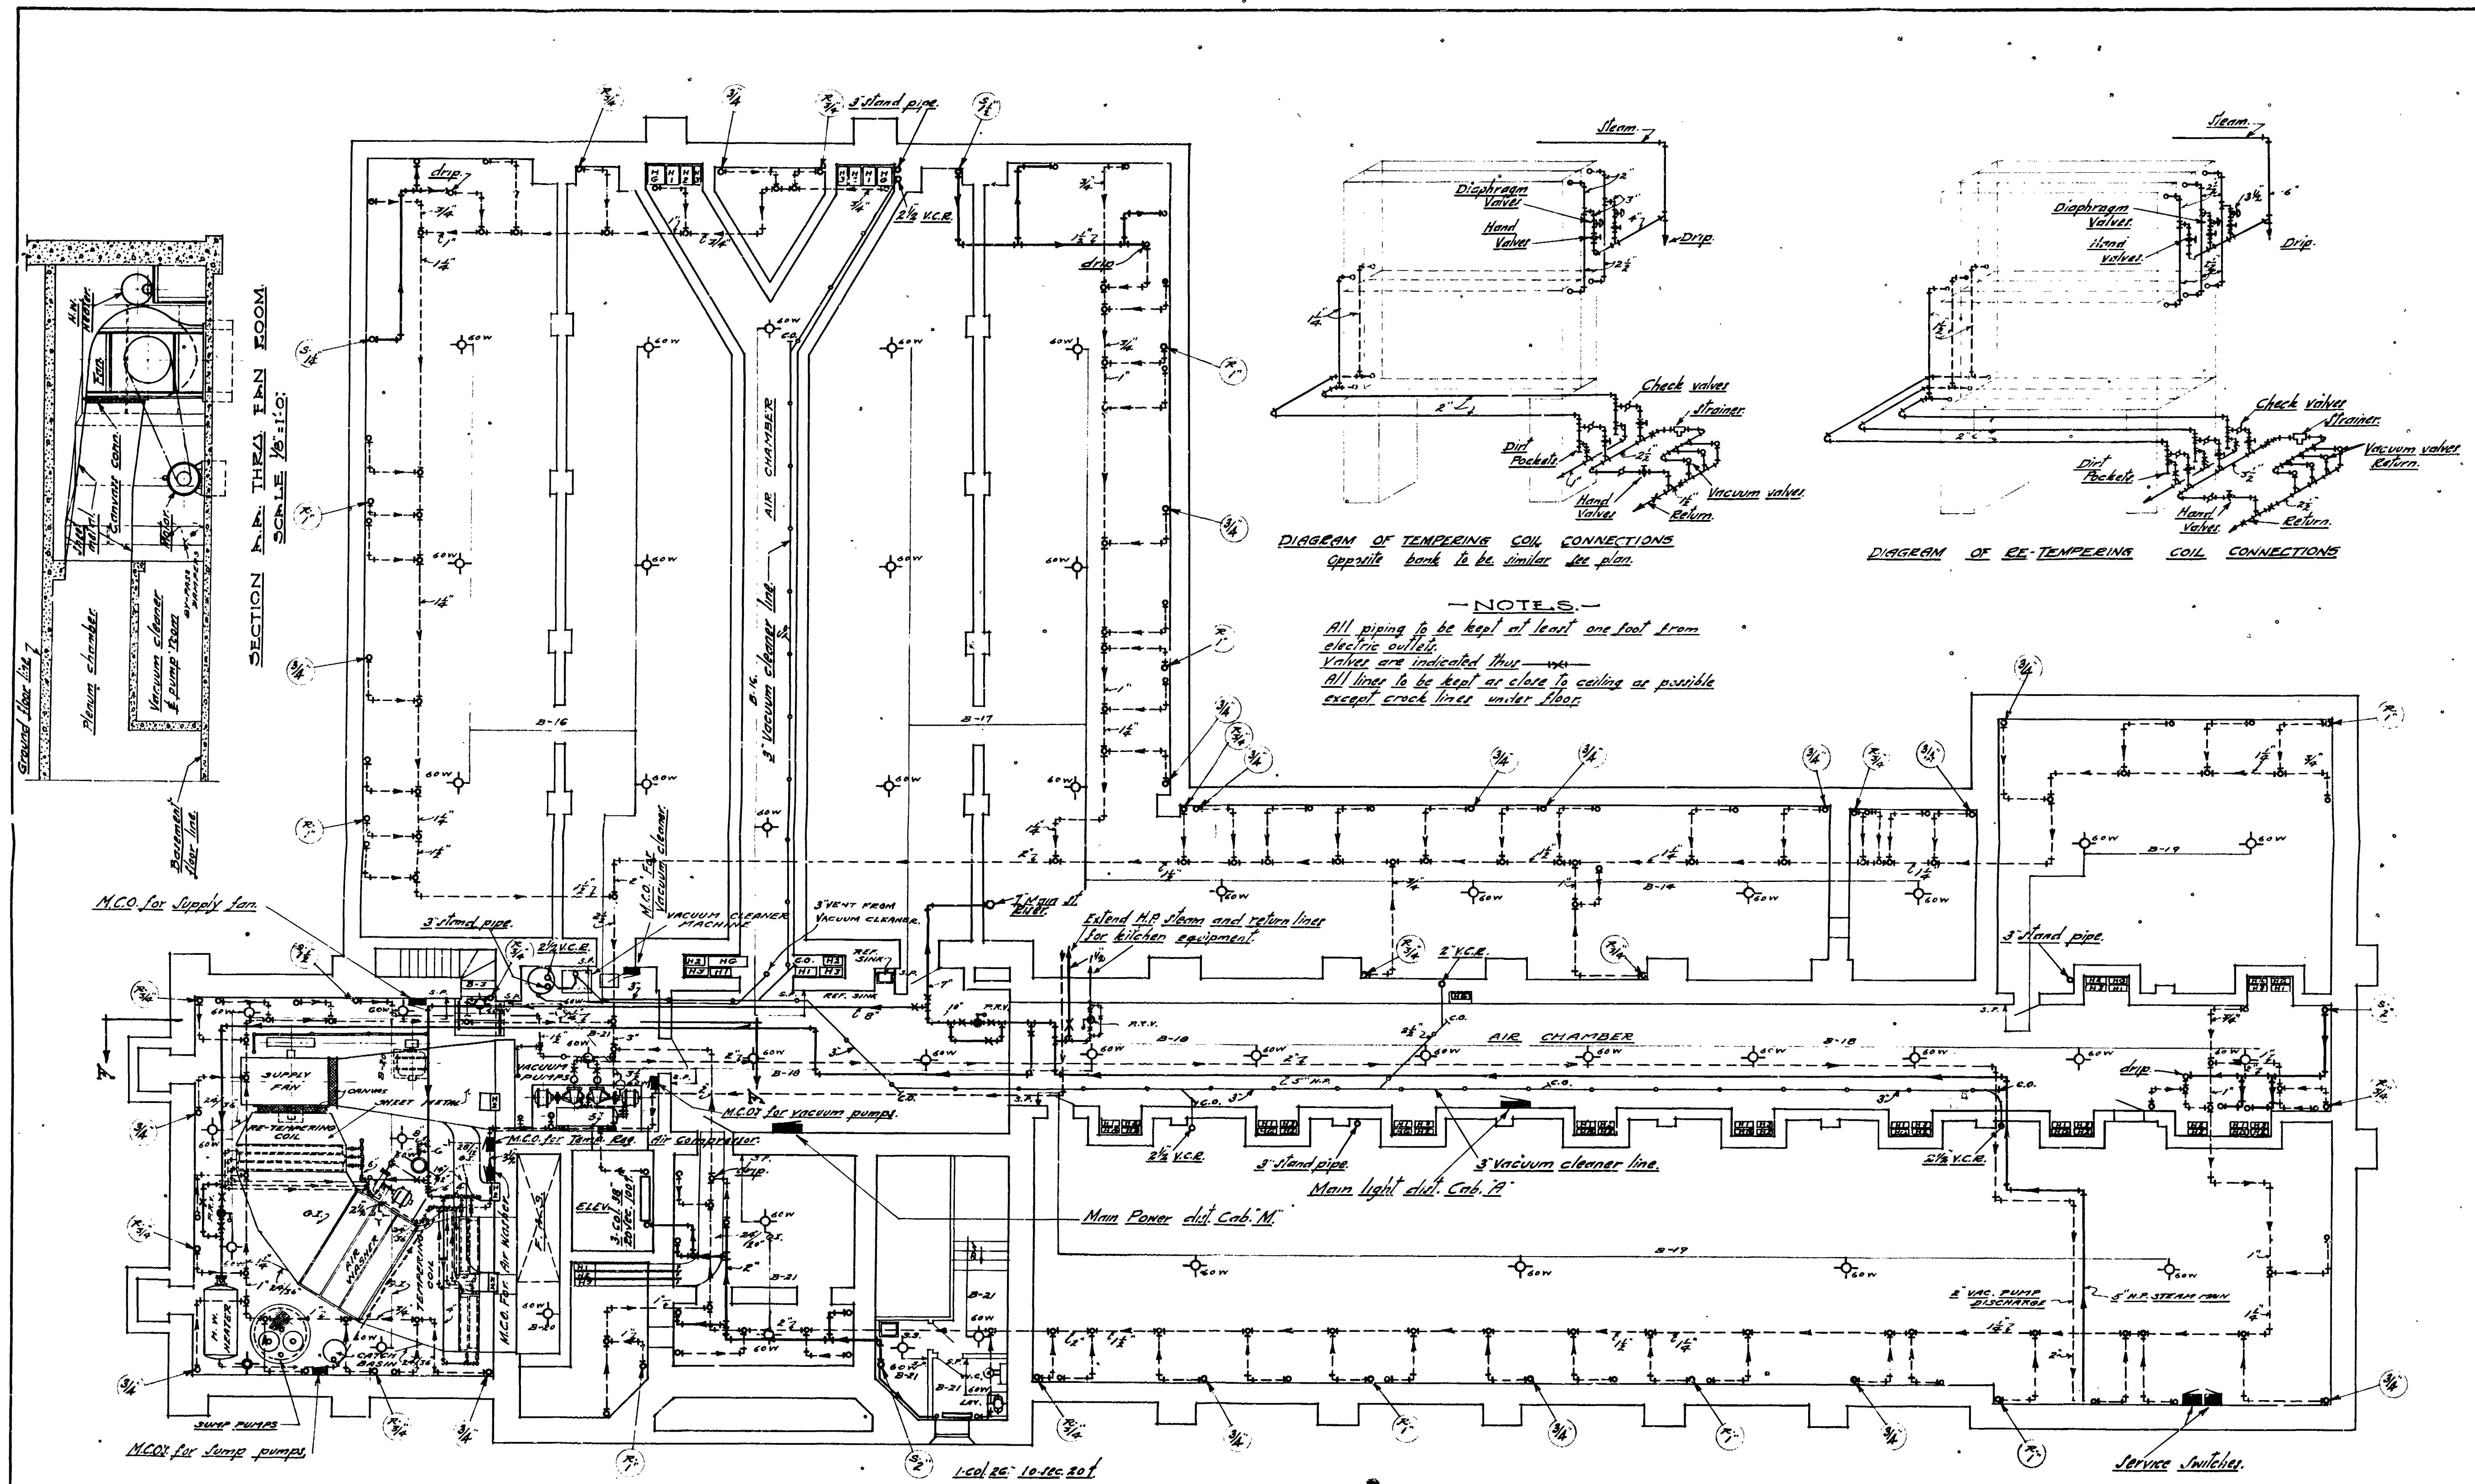

HEATING. VENTILATING. PLUMBING.
AND
ELECTRIC WIRING. SYSTEMS.

BASEMENT PLAN
SCALE 1/8'-1'-0"


B-17-72

EDWYN A. BOND.
ARCHITECT
LANSING, MICHIGAN.

SERVICE EQUIPMENT
HOME ECONOMICS BUILDING
MICHIGAN AGRICULTURAL COLLEGE
APPROVED BY *G. R. Bond* M.E.

1

DATE
6-28-22

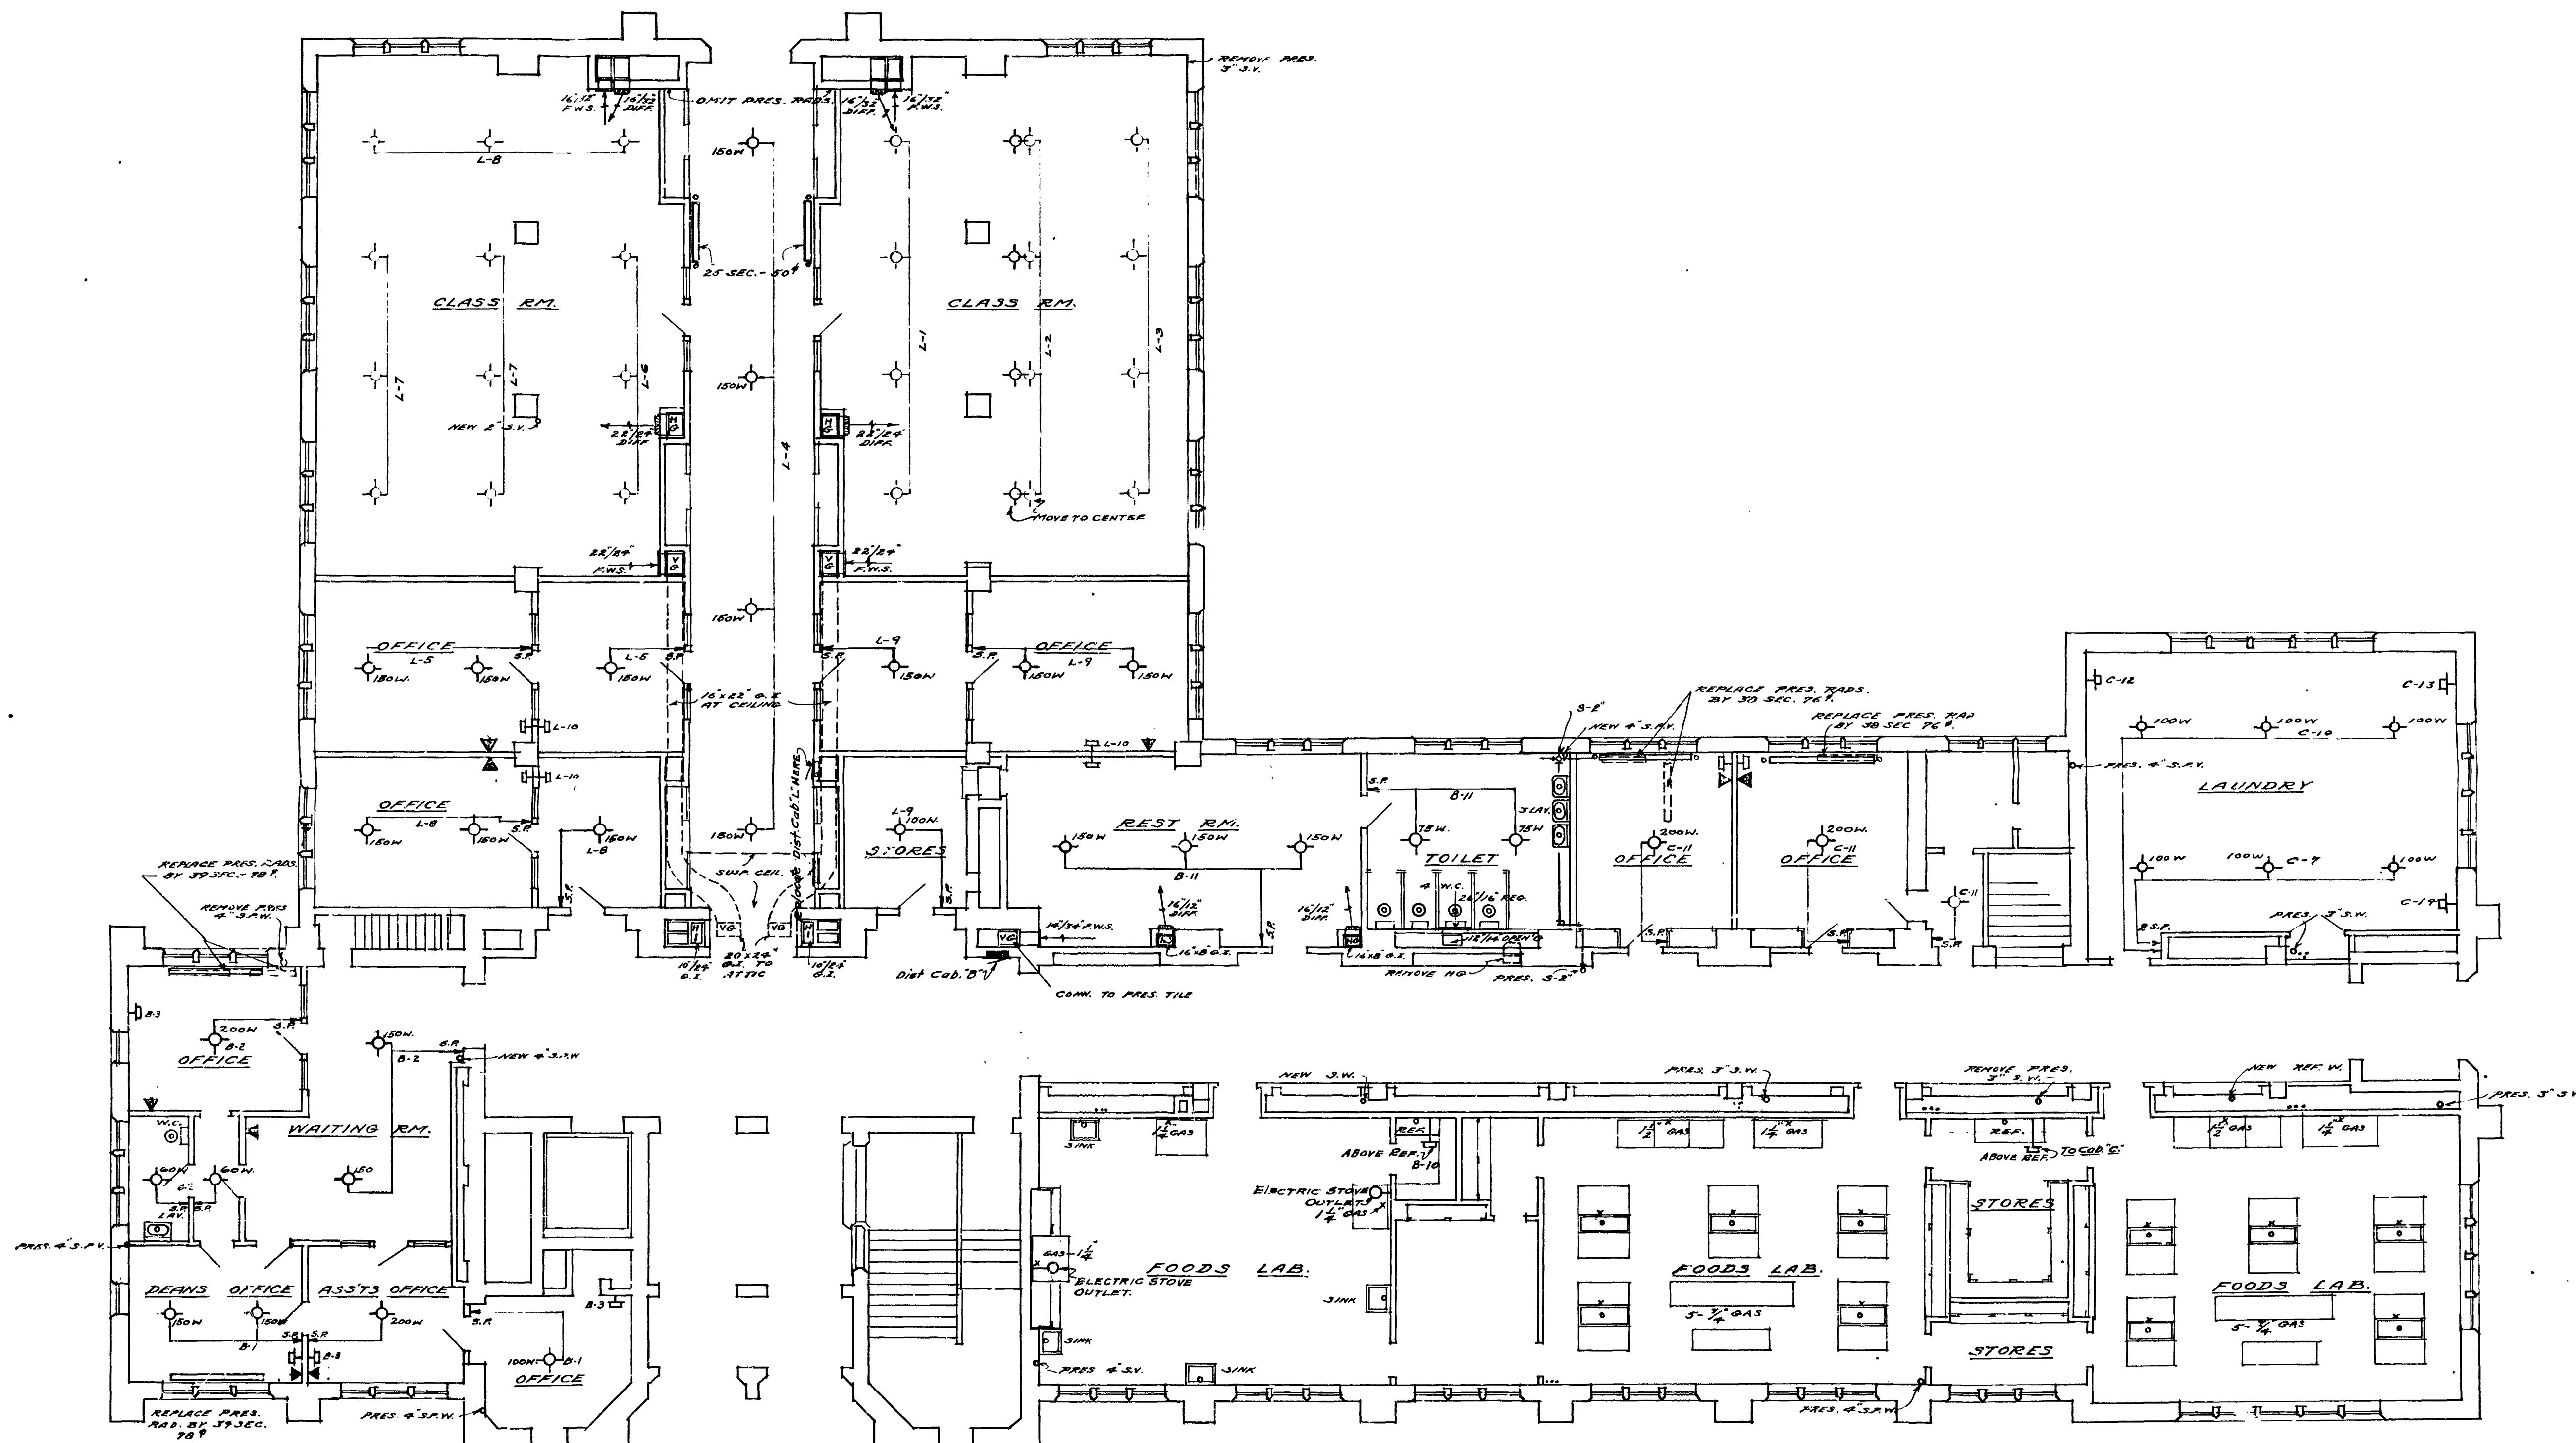


REVISED GROUND FLOOR PLAN
SCALE 1"-0"

B-17-74

EDWYN A. BOWD.
ARCHITECT
LANSING MICHIGAN

SERVICE EQUIPMENT
HOME ECONOMICS BUILDING
MICHIGAN AGRICULTURAL COLLEGE
APPROVED BY

2

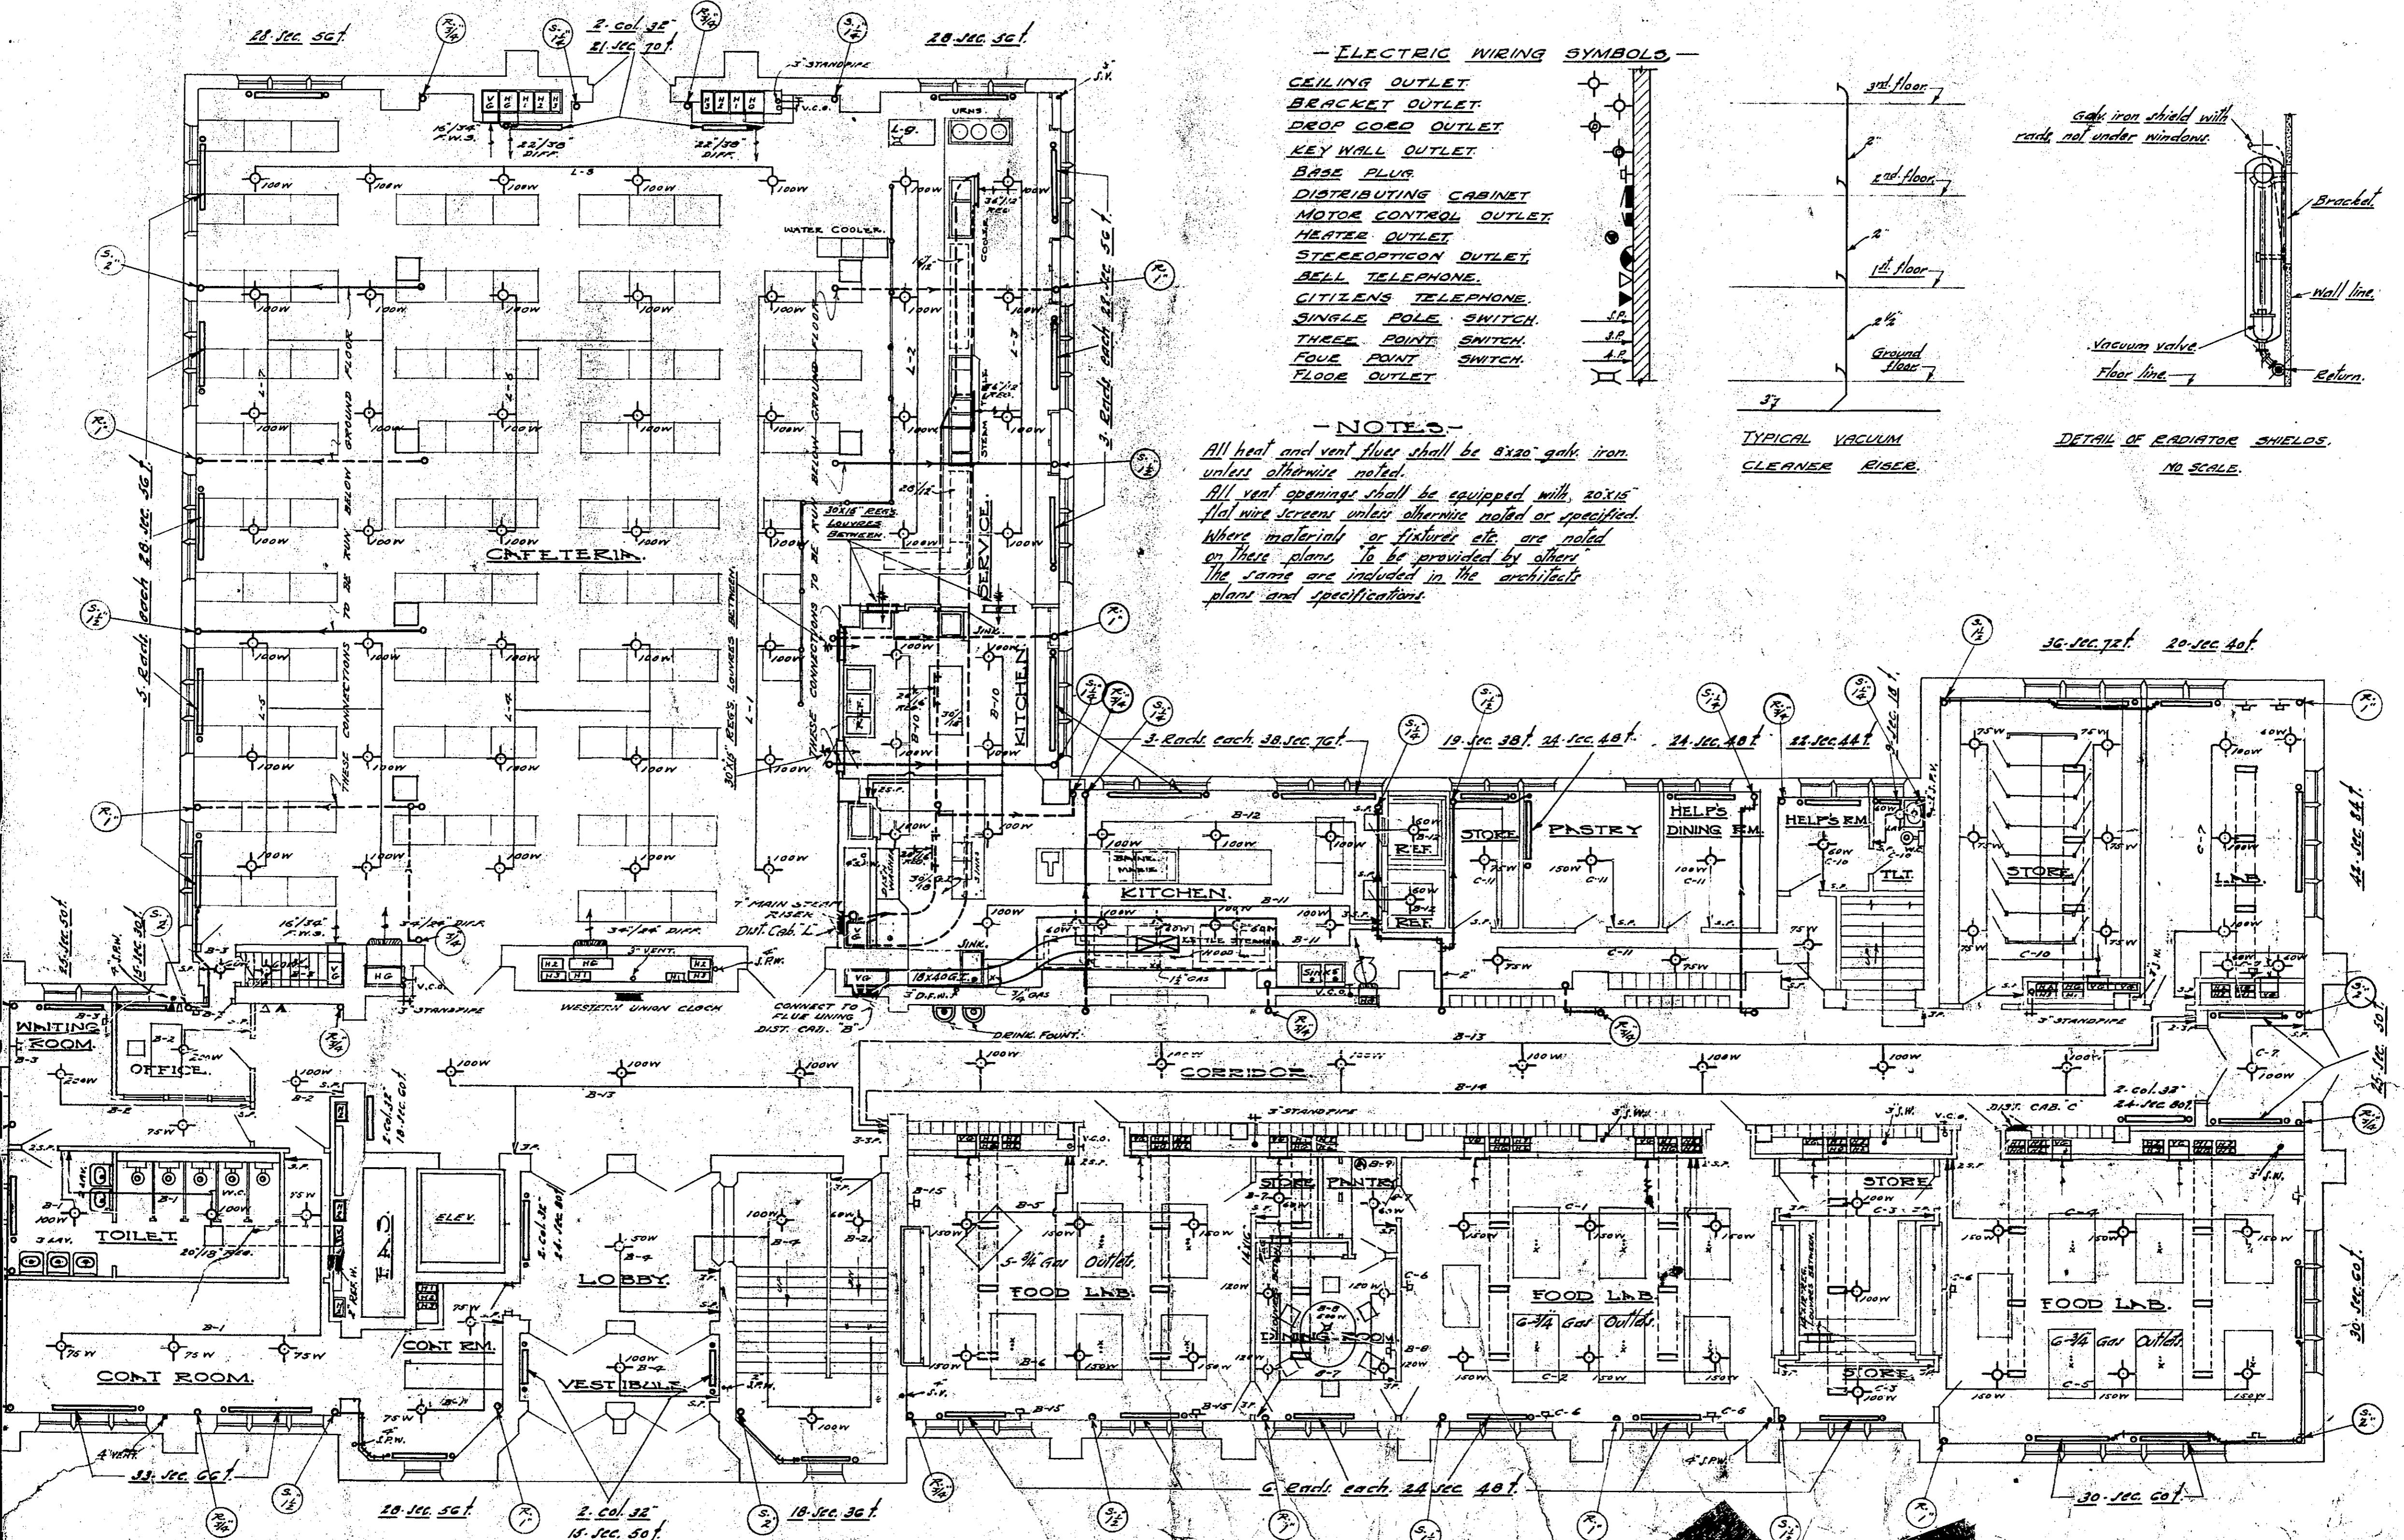


Note- All radiators on this floor to be 1 col 26 unless otherwise noted.

GROUND FLOOR PLAN


SCALE. 1/8". 1'-0"

EDWYN
ARC
LANSING

SERVICE EQUIPMENT
HOME ECONOMICS BUILDING
MICHIGAN AGRICULTURAL COLLEGE
APPROVED BY Jim Bissell M.E.

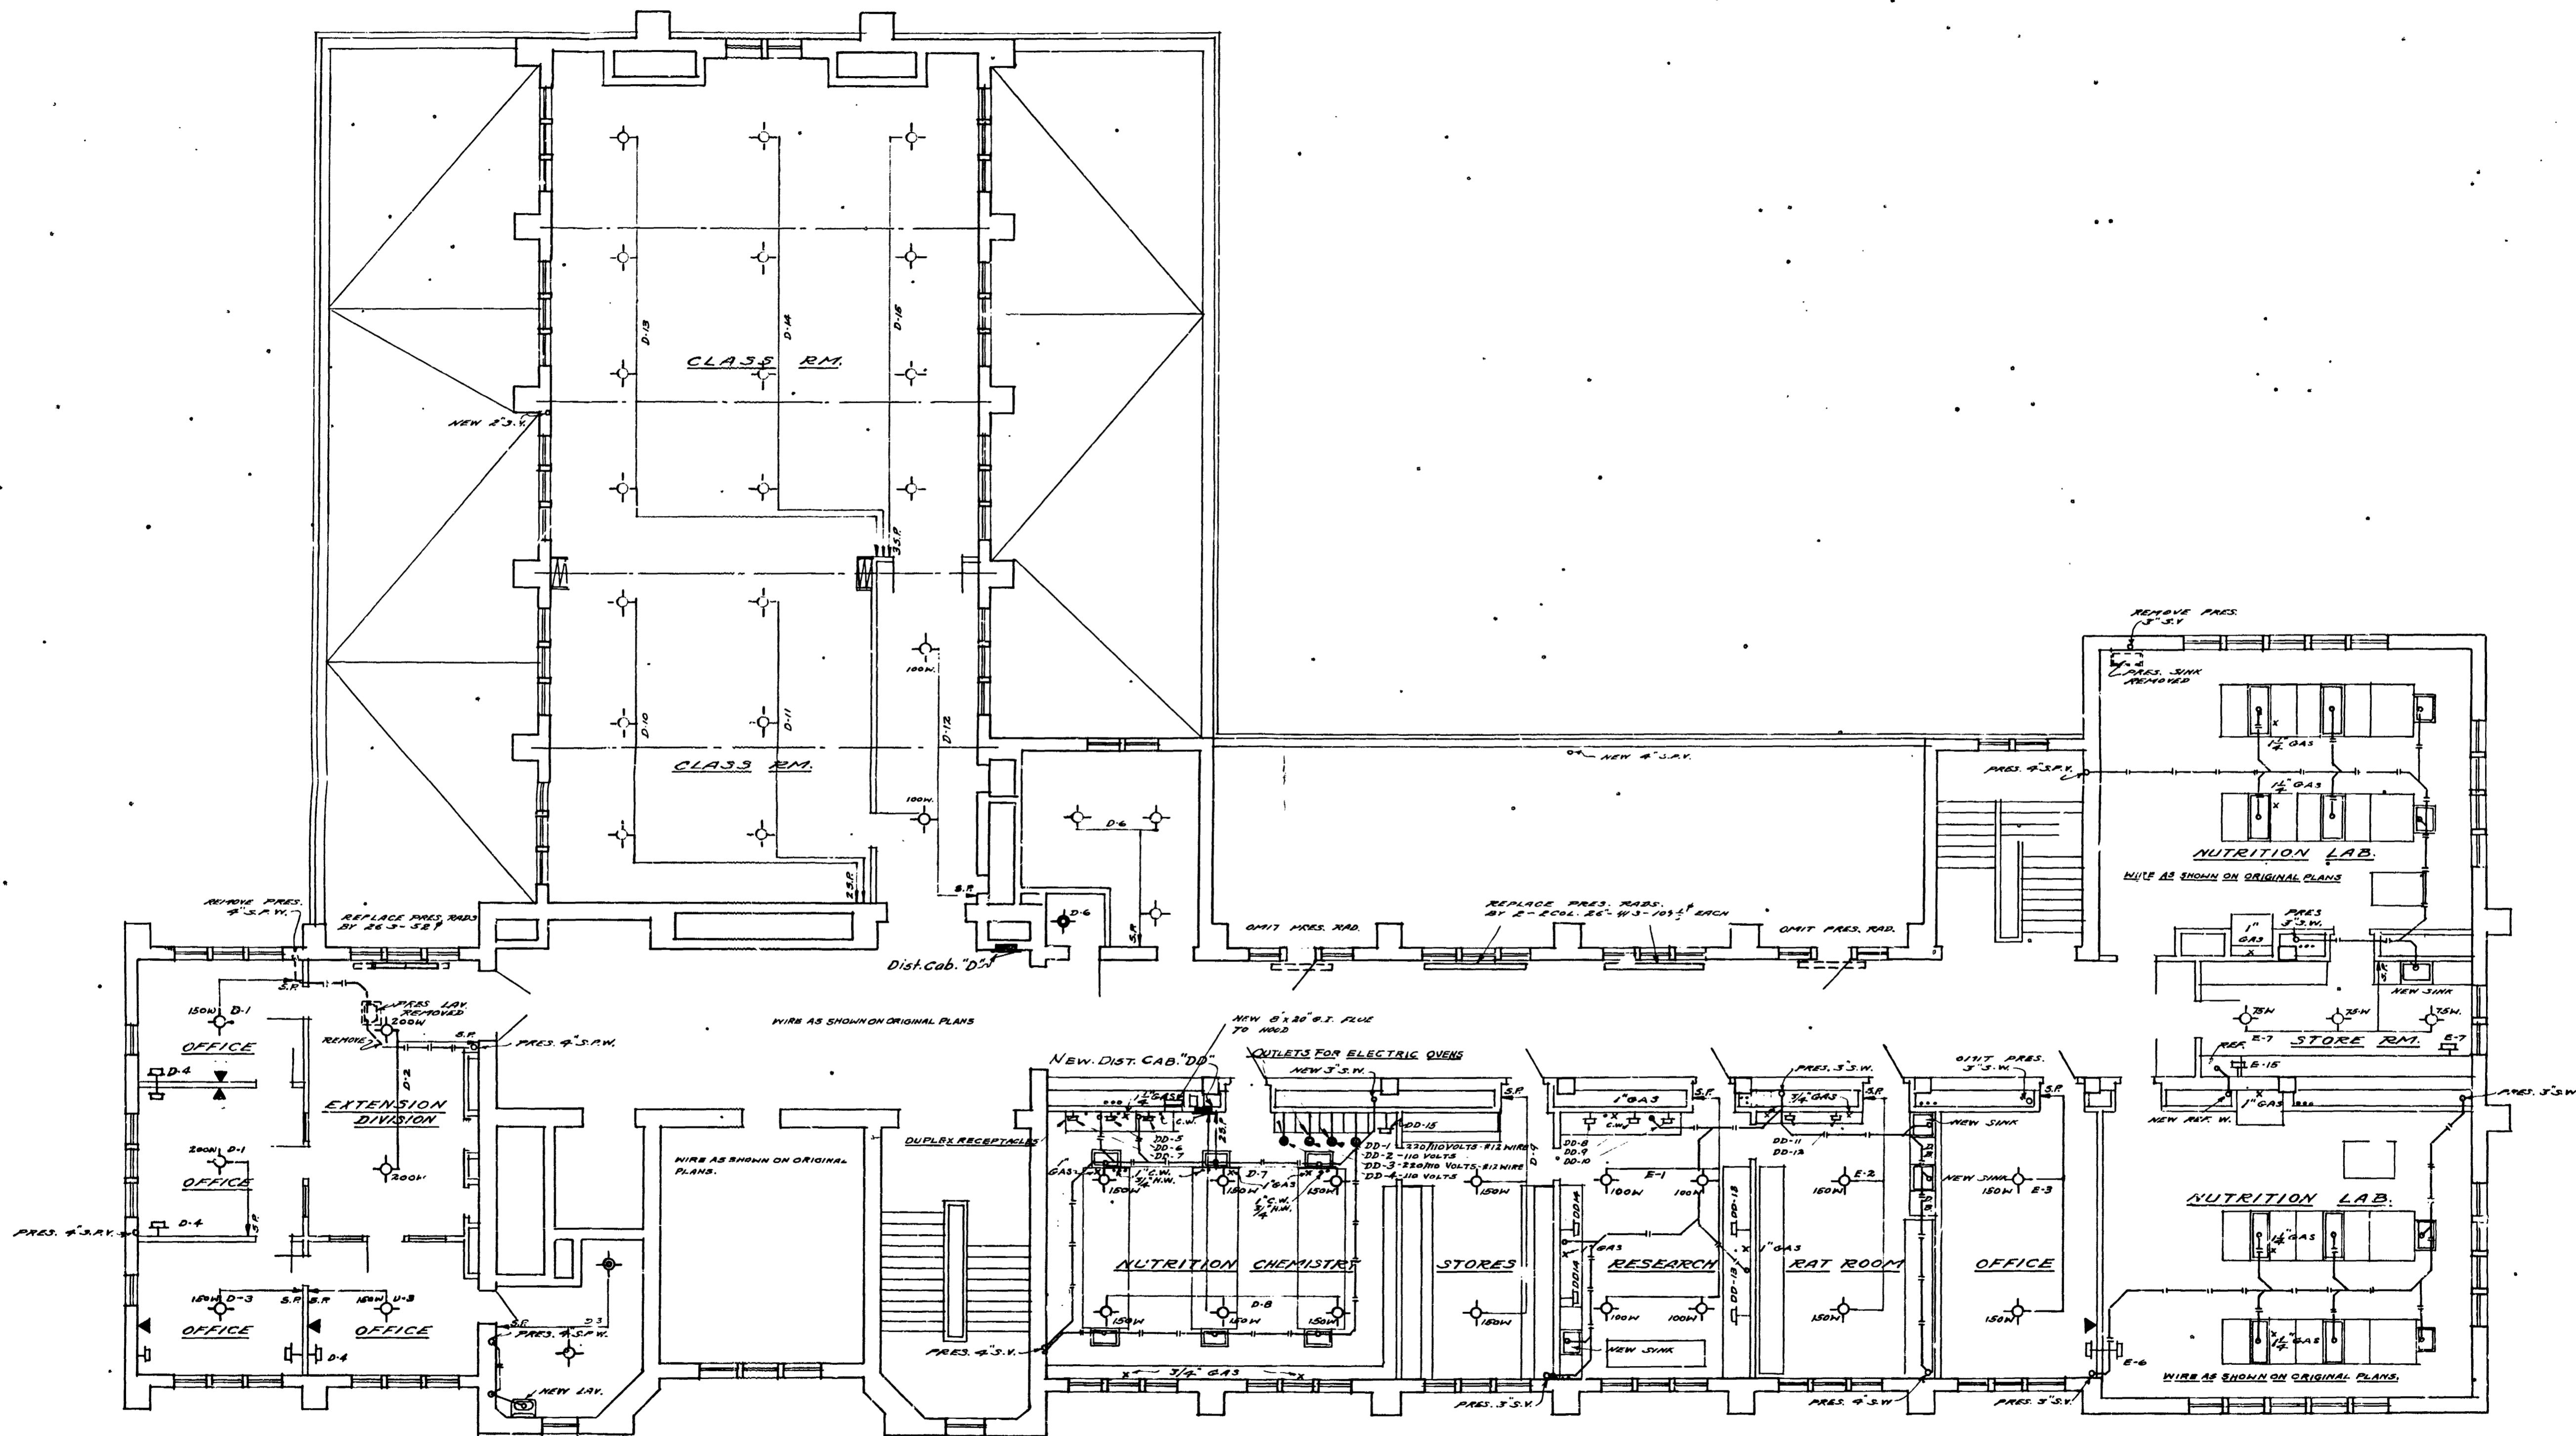

B-17-70

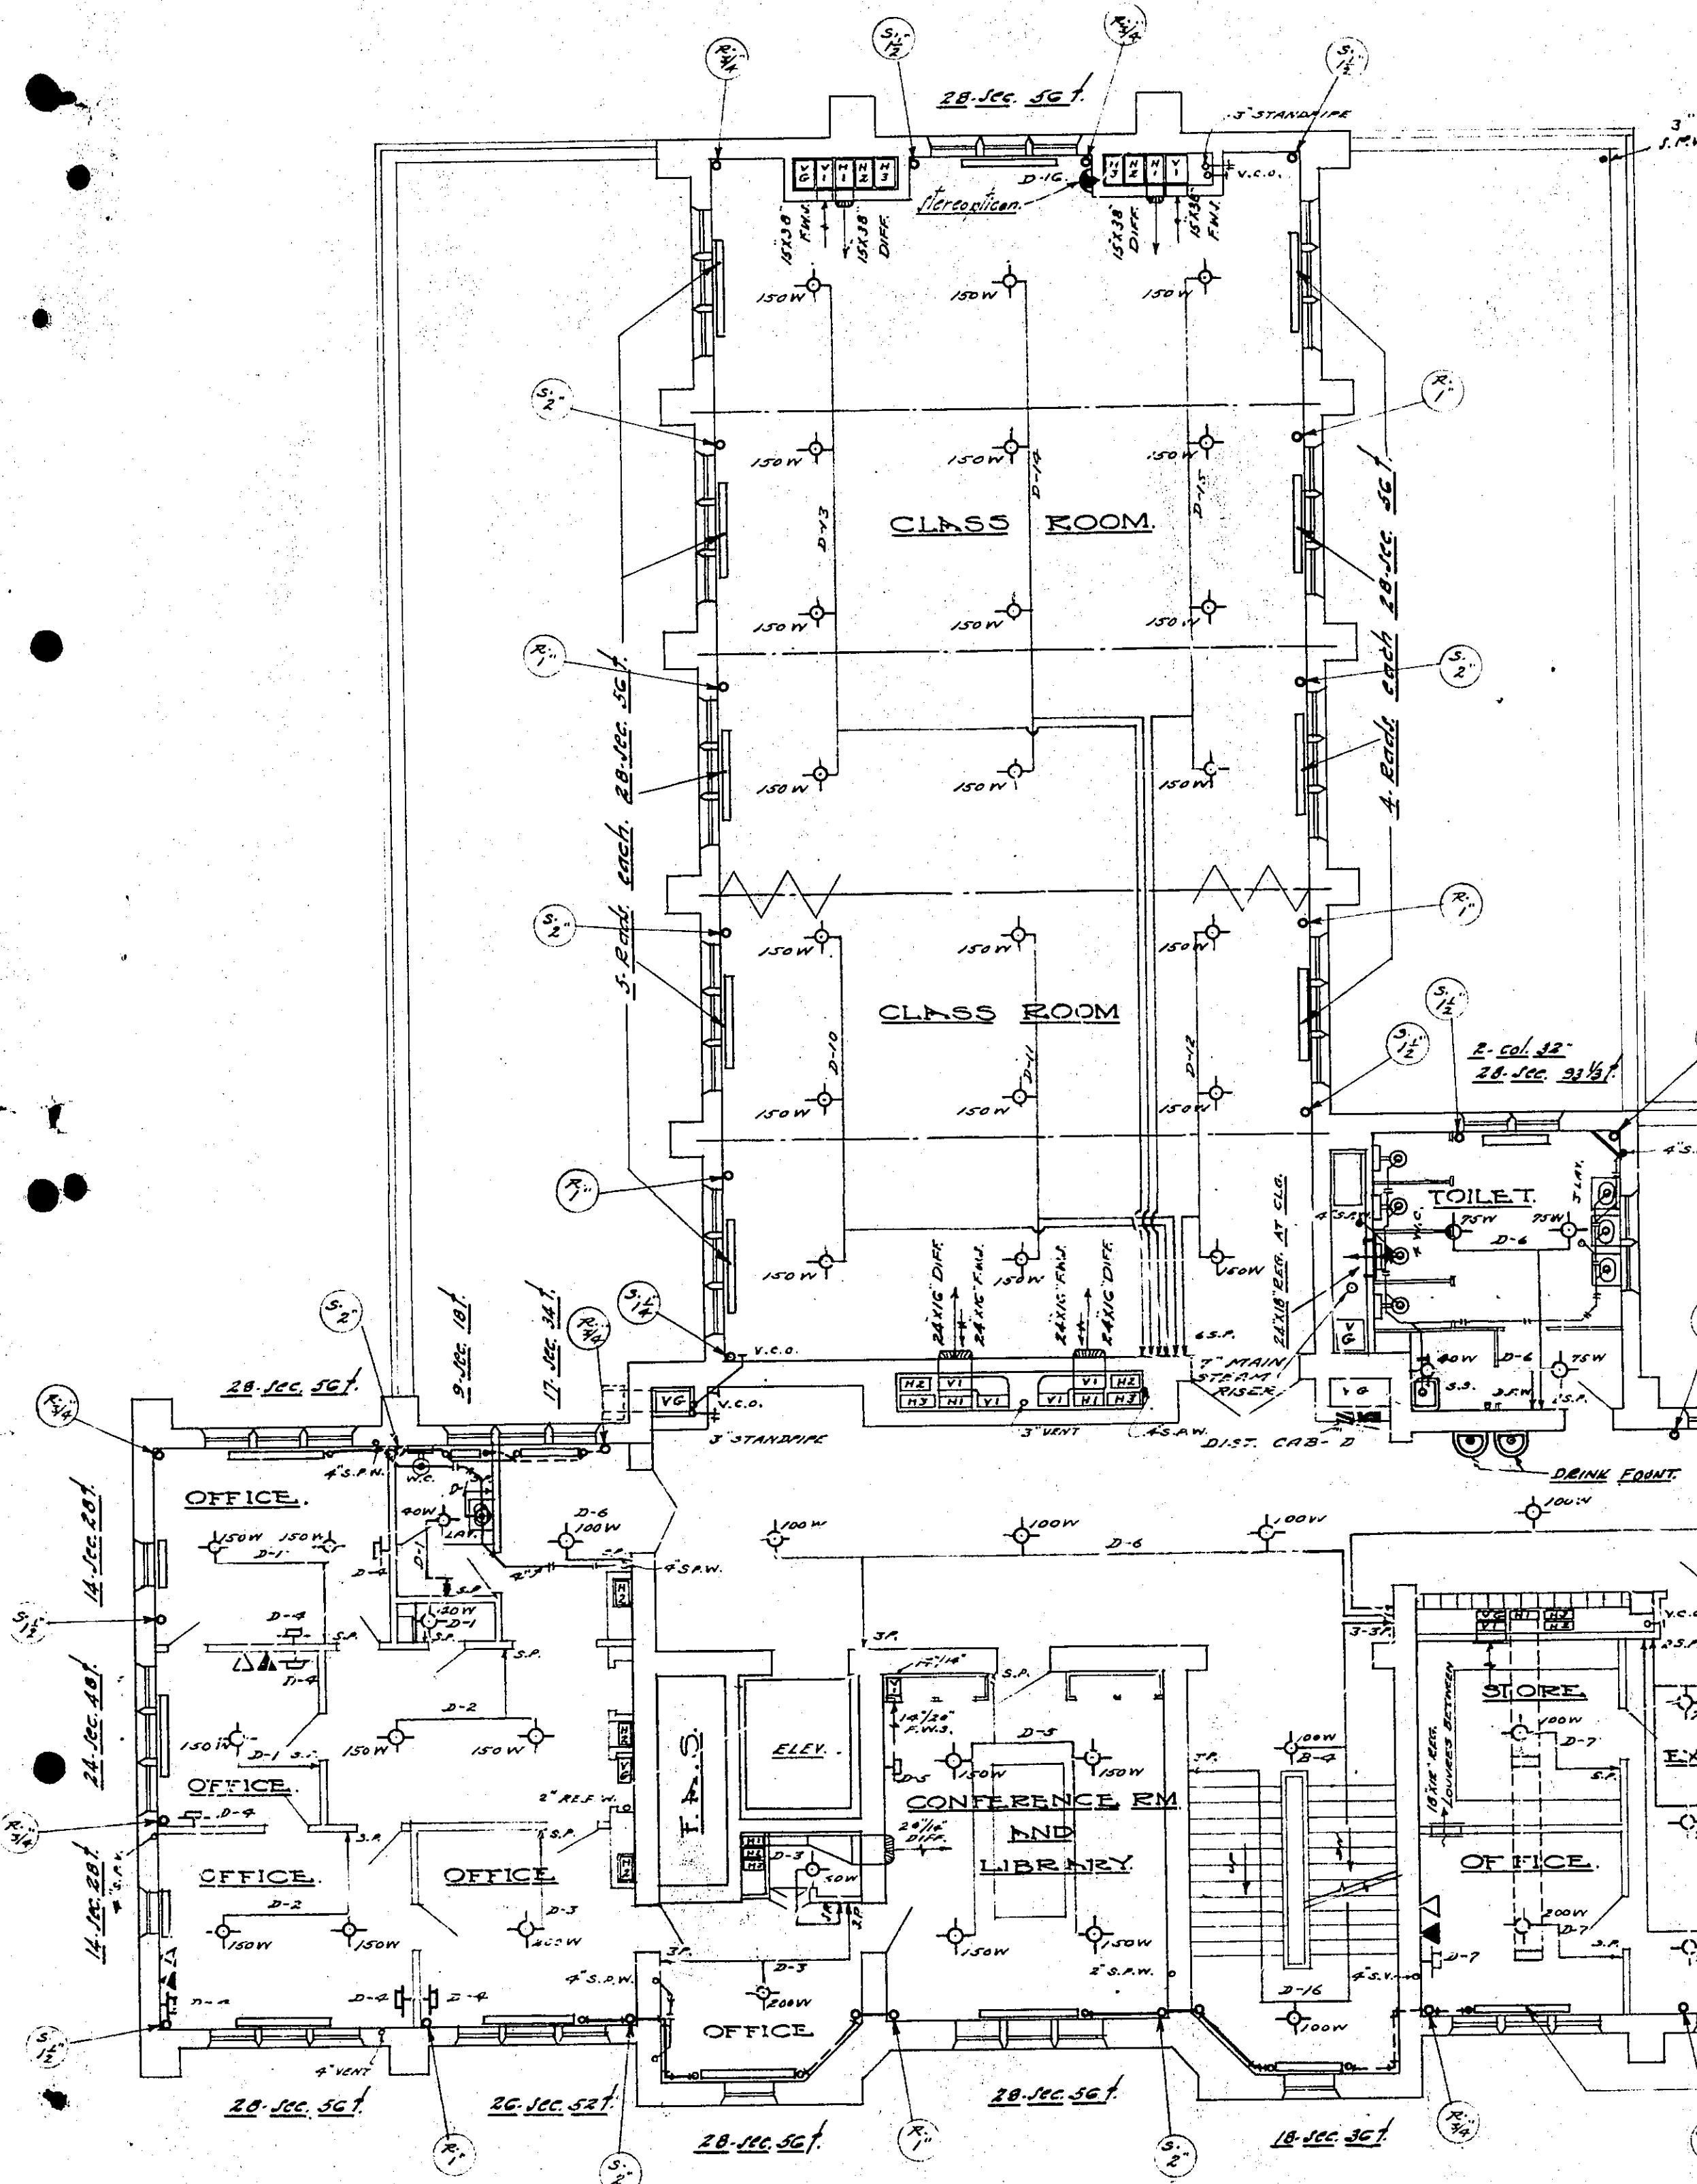

FIRST FLOOR PLAN.

SCALE 1/8:10


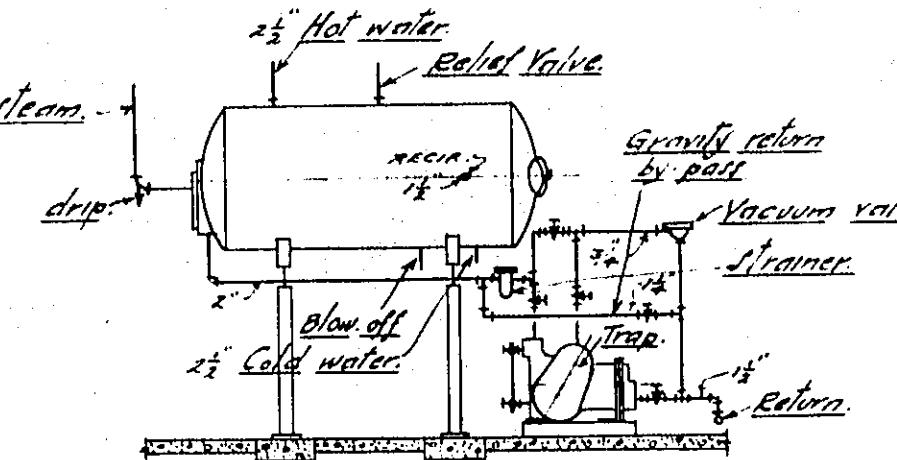



DIAGRAM OF SERVICE WATER HEATER.
SHOWING CONNECTIONS ETC.
SCALE 1/4:10


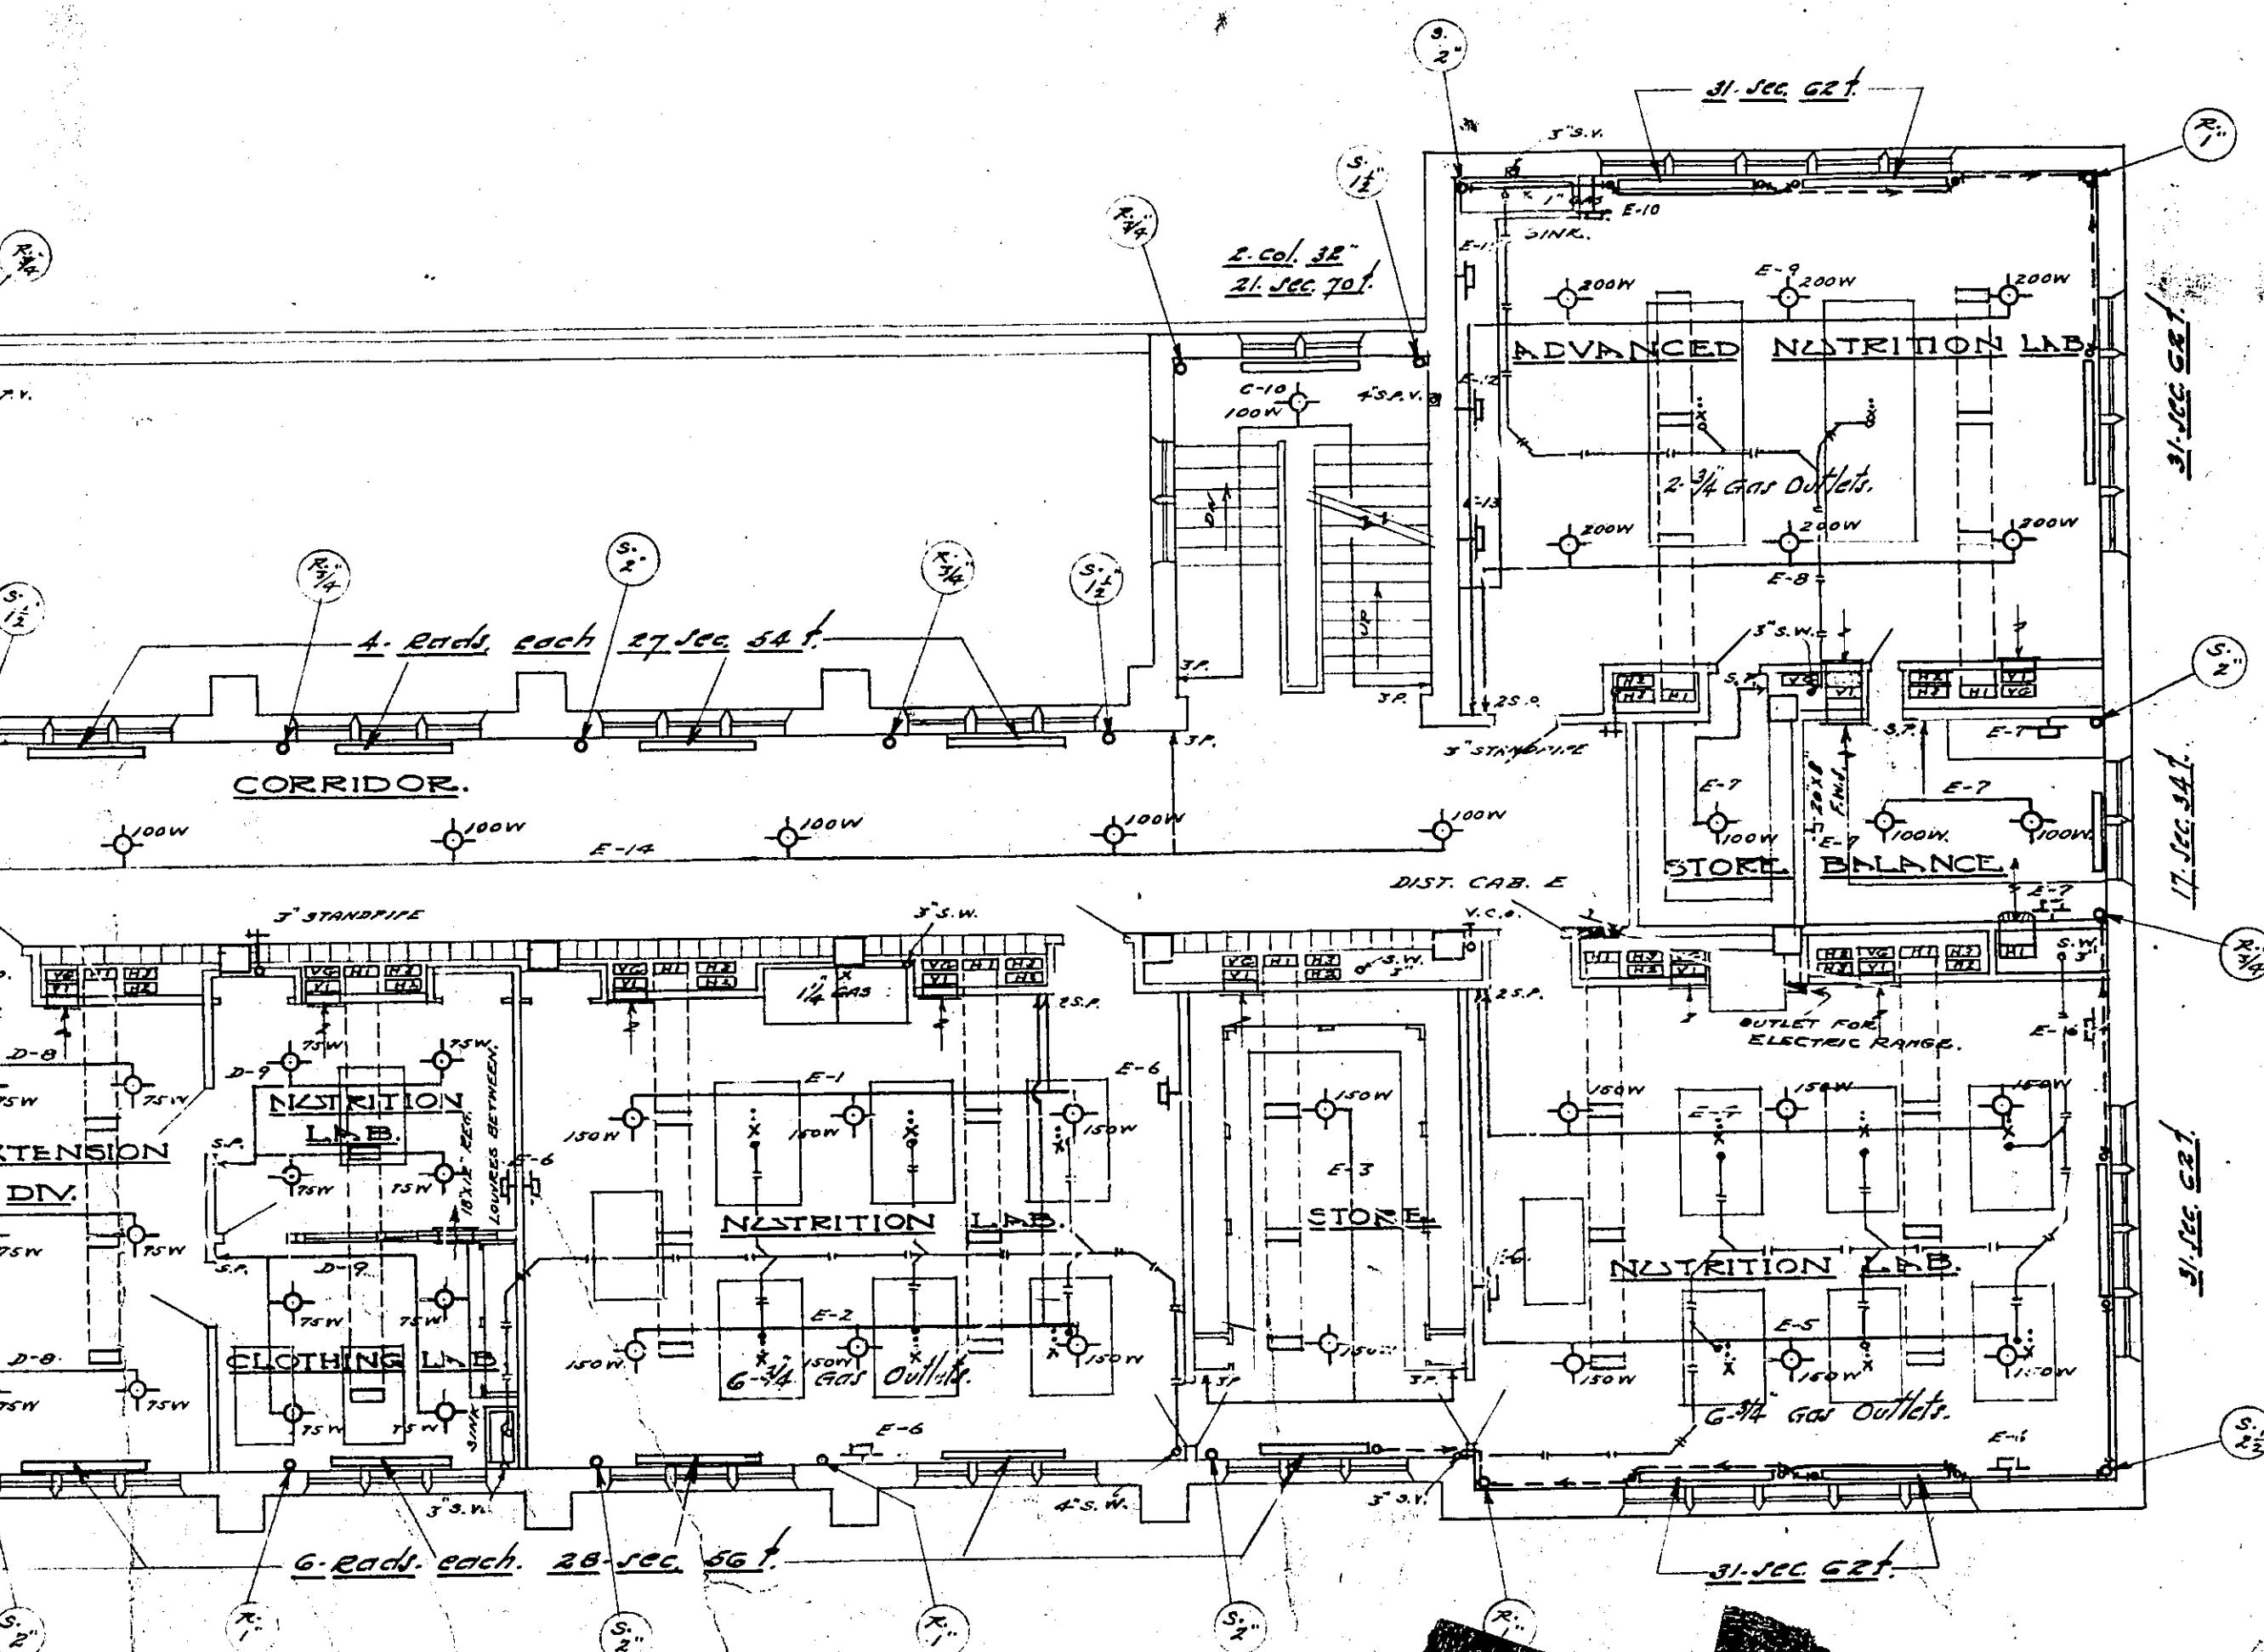


Note -
All radiators on this floor to be 1-col 26
unless otherwise noted.

EDWYN B. B.
ARCHITECT
LANDING

MENT
OMIC BUILDING
GRICULTURAL COLLEGE
D BY Bar Biell ME
DATE 6-23-22

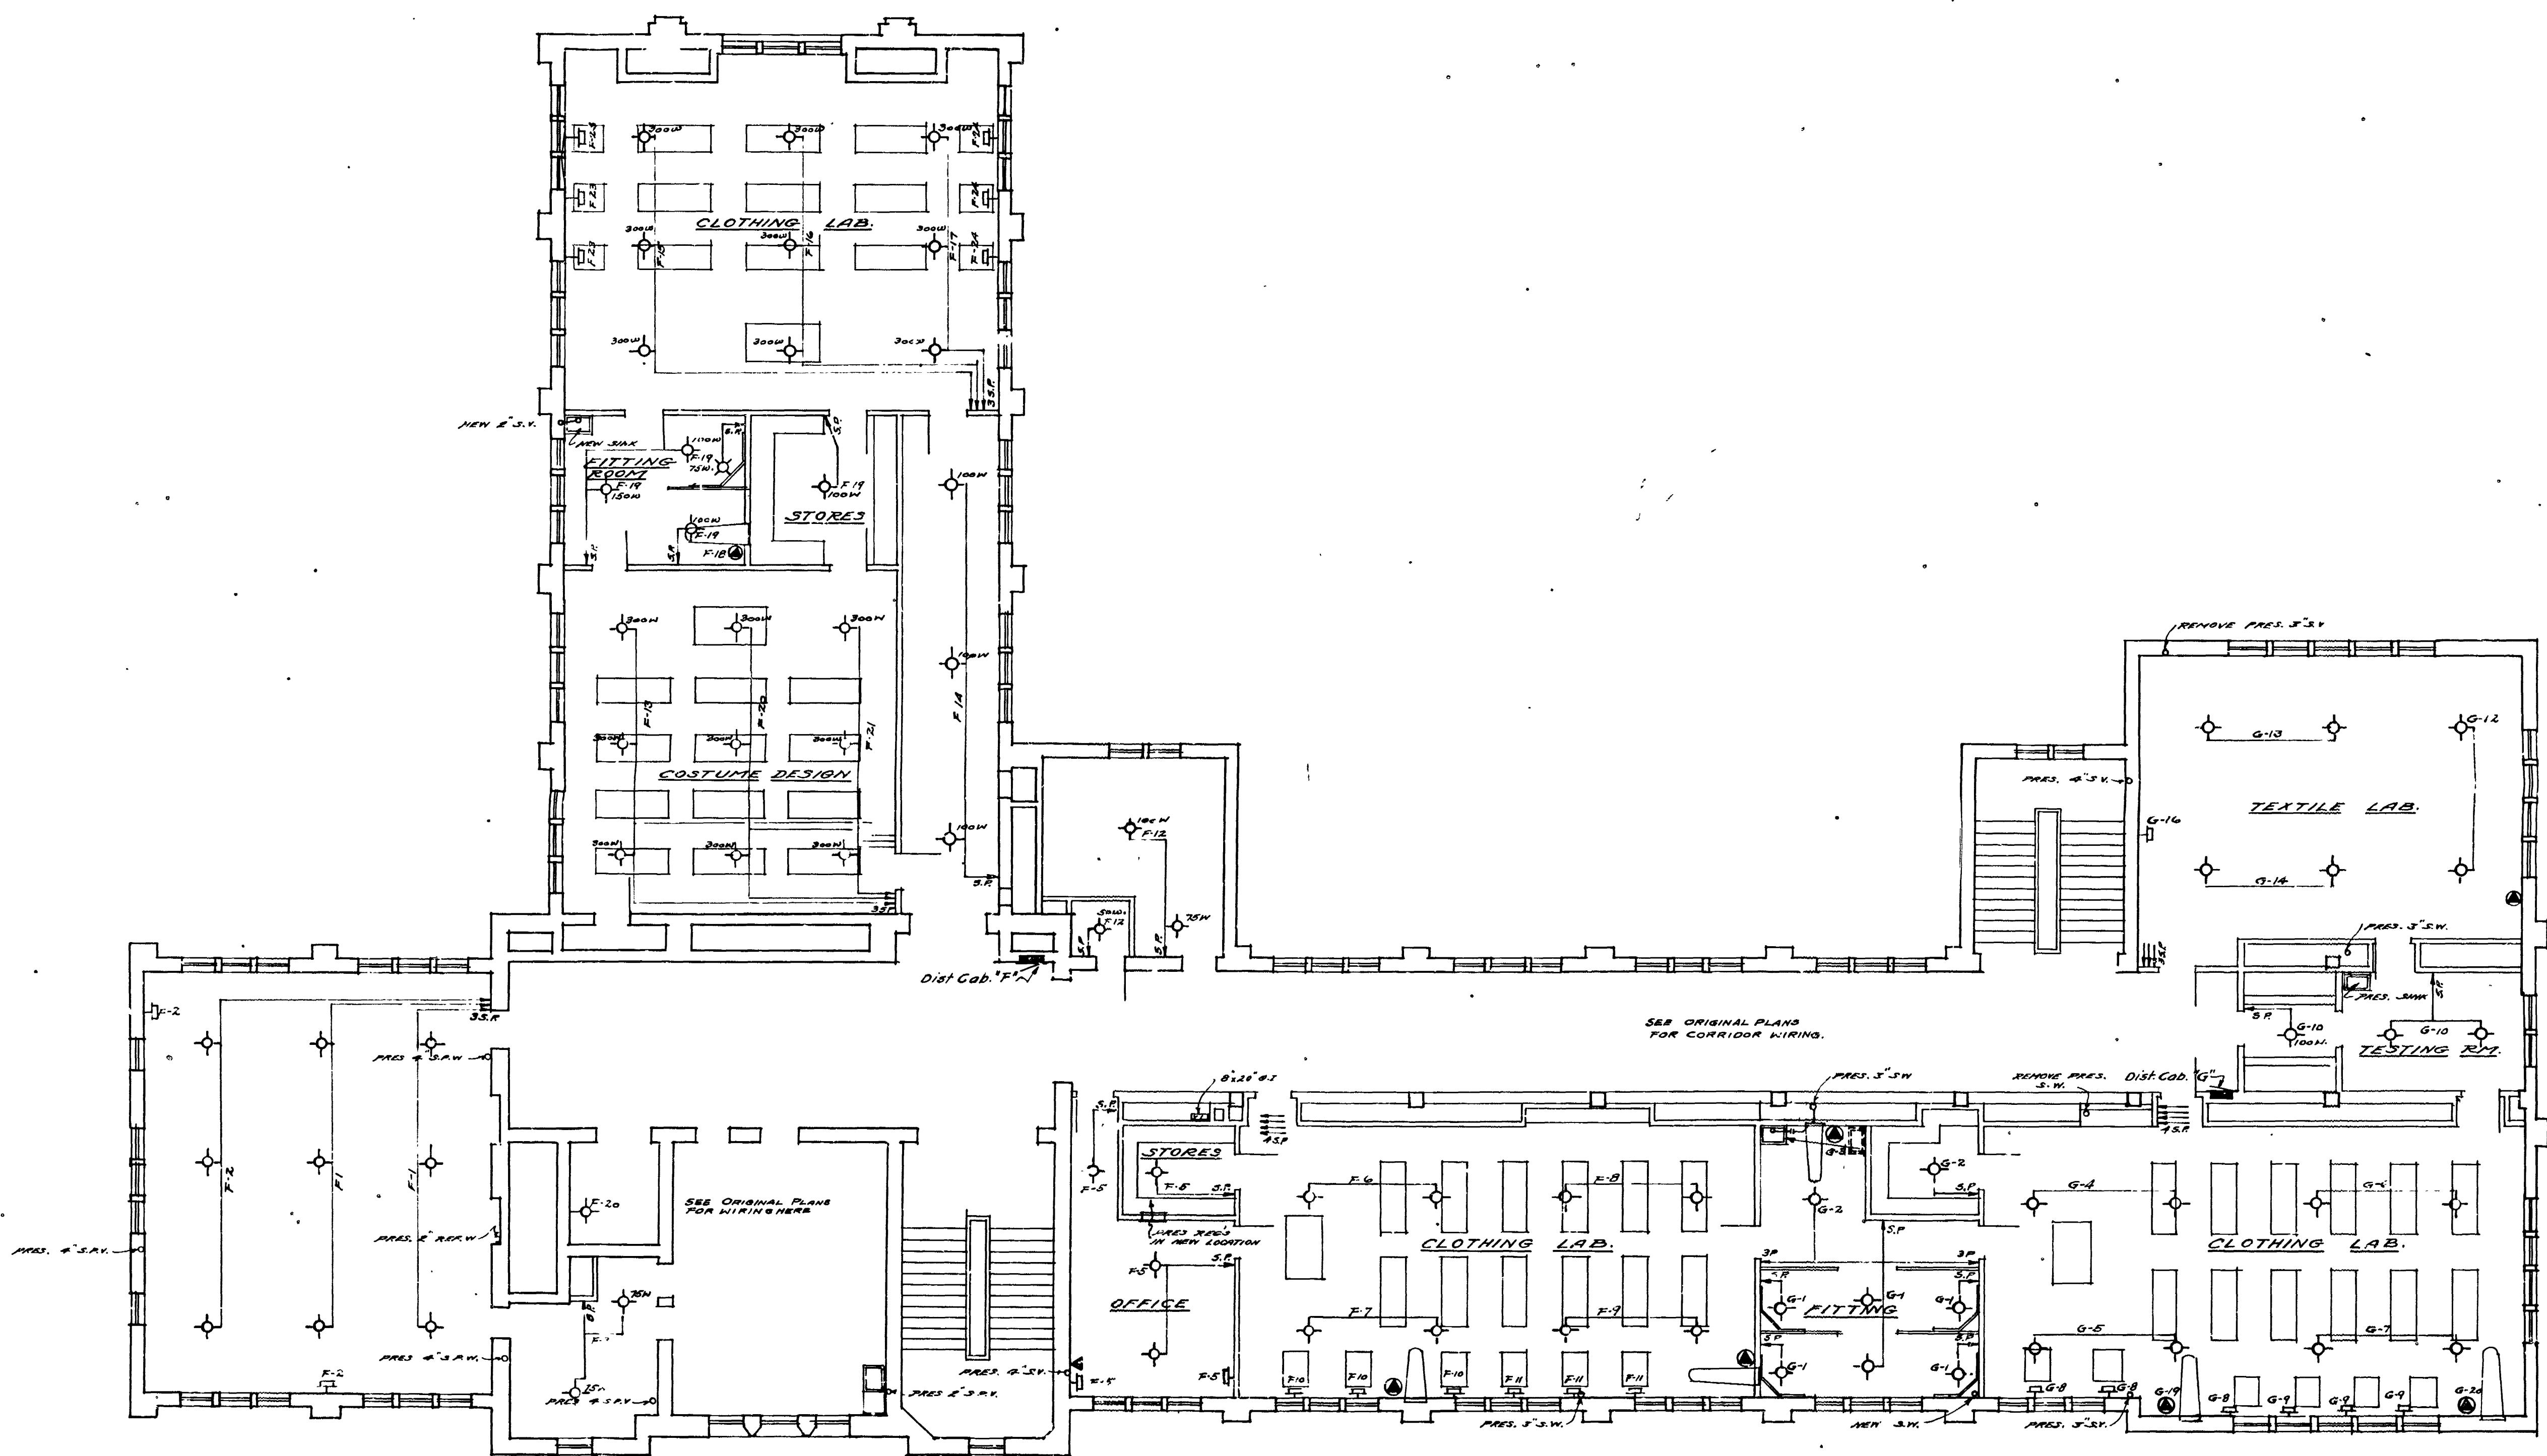

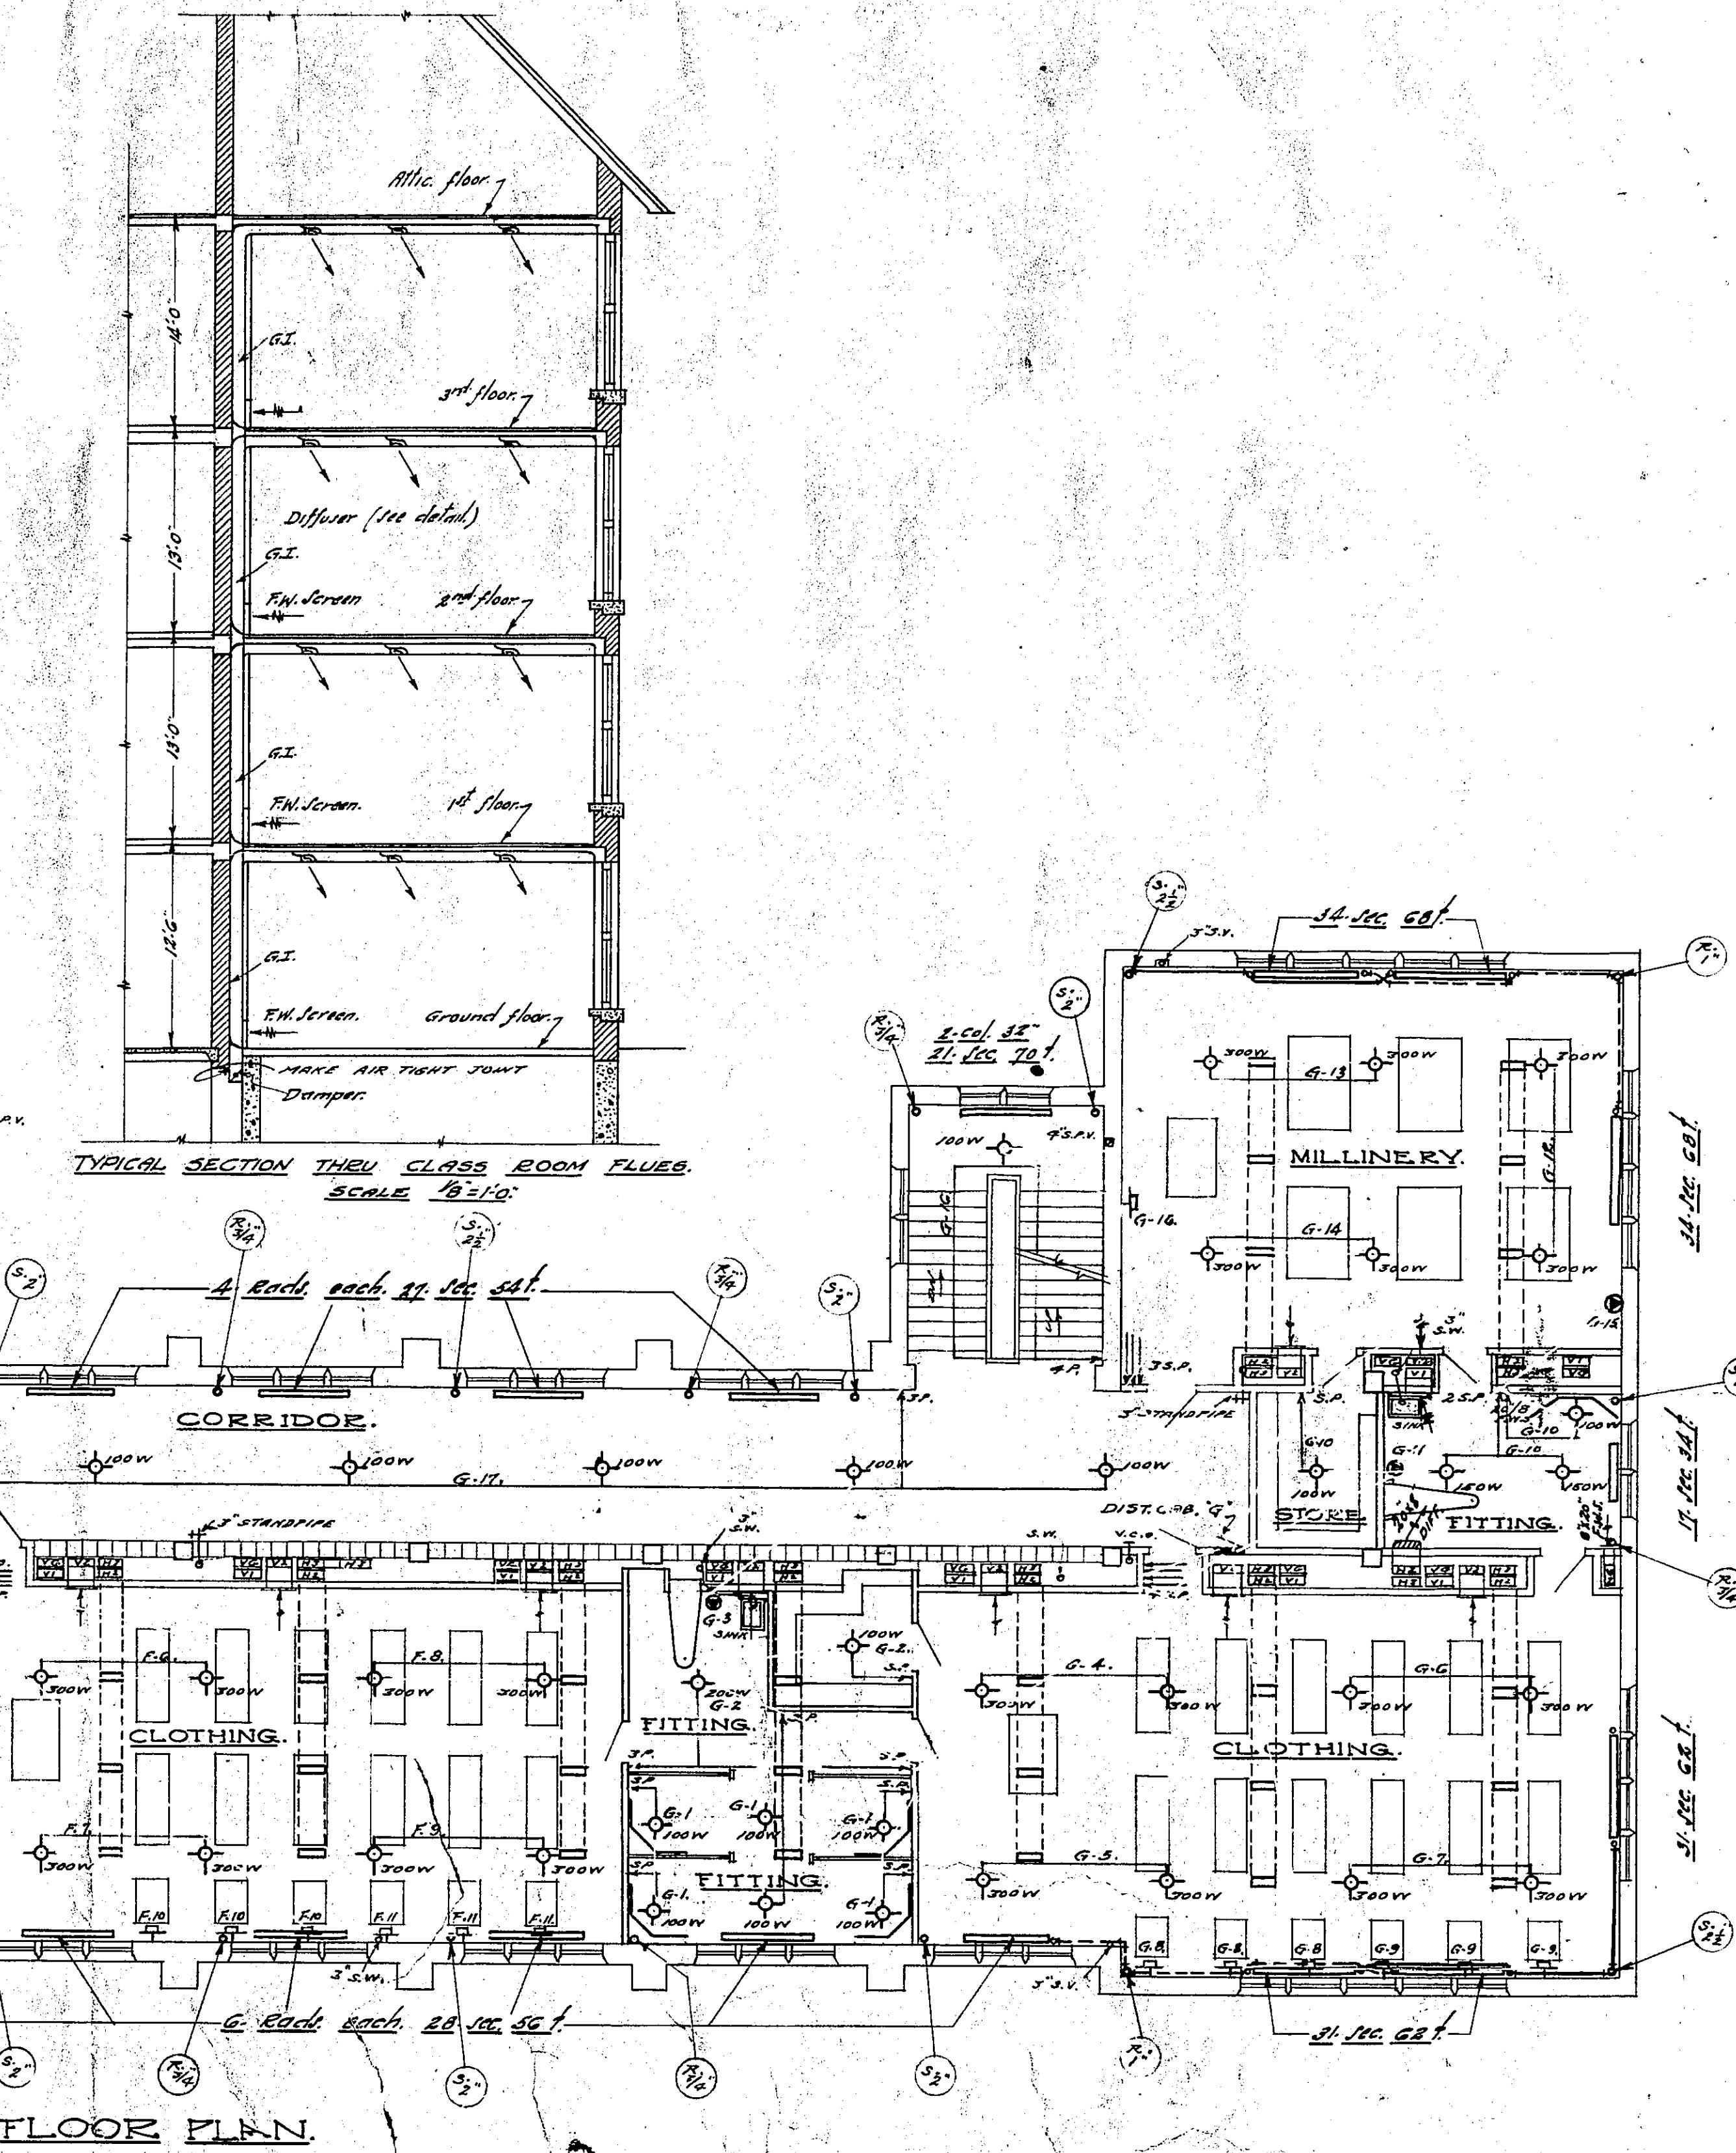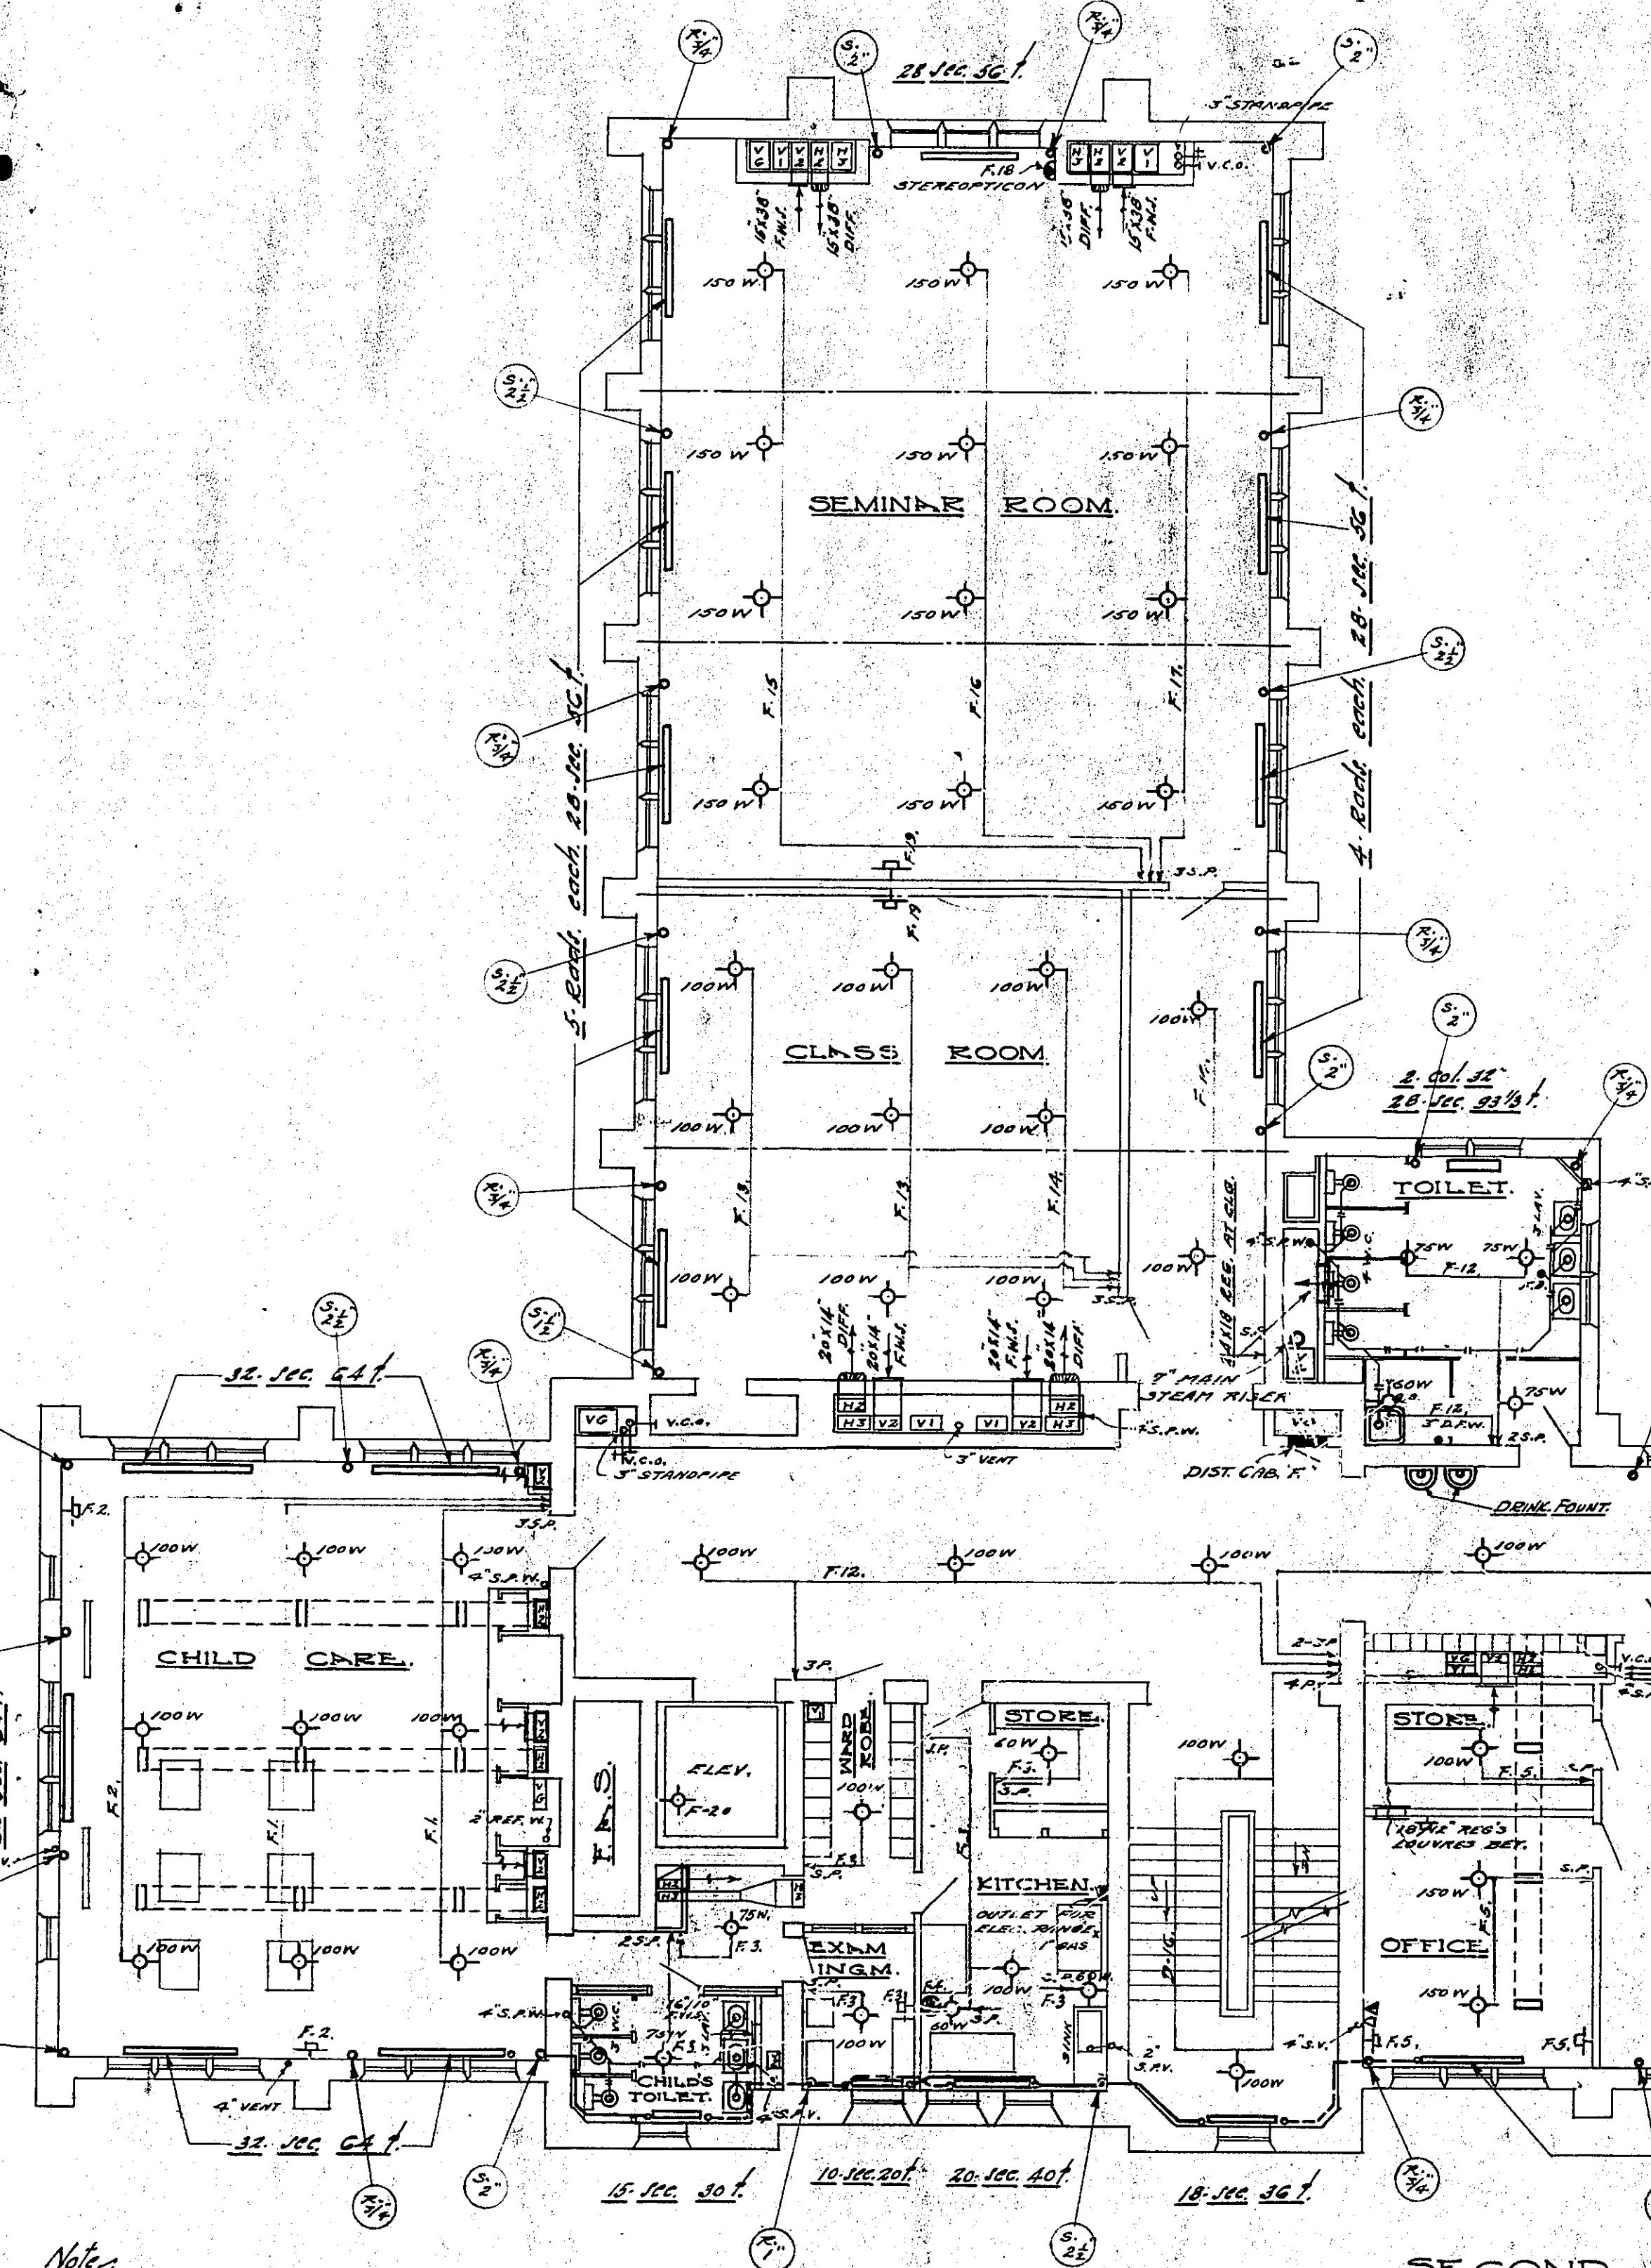


EDWIN A. BOWD.
ARCHITECT
LANSING, MICHIGAN.


SERVICE EQUIPMENT.
HOME ECONOMICS BUILDING.
MICHIGAN AGRICULTURAL COLLEGE
APPROVED by Mr. Russell ME.

4

DATE
6-23-22

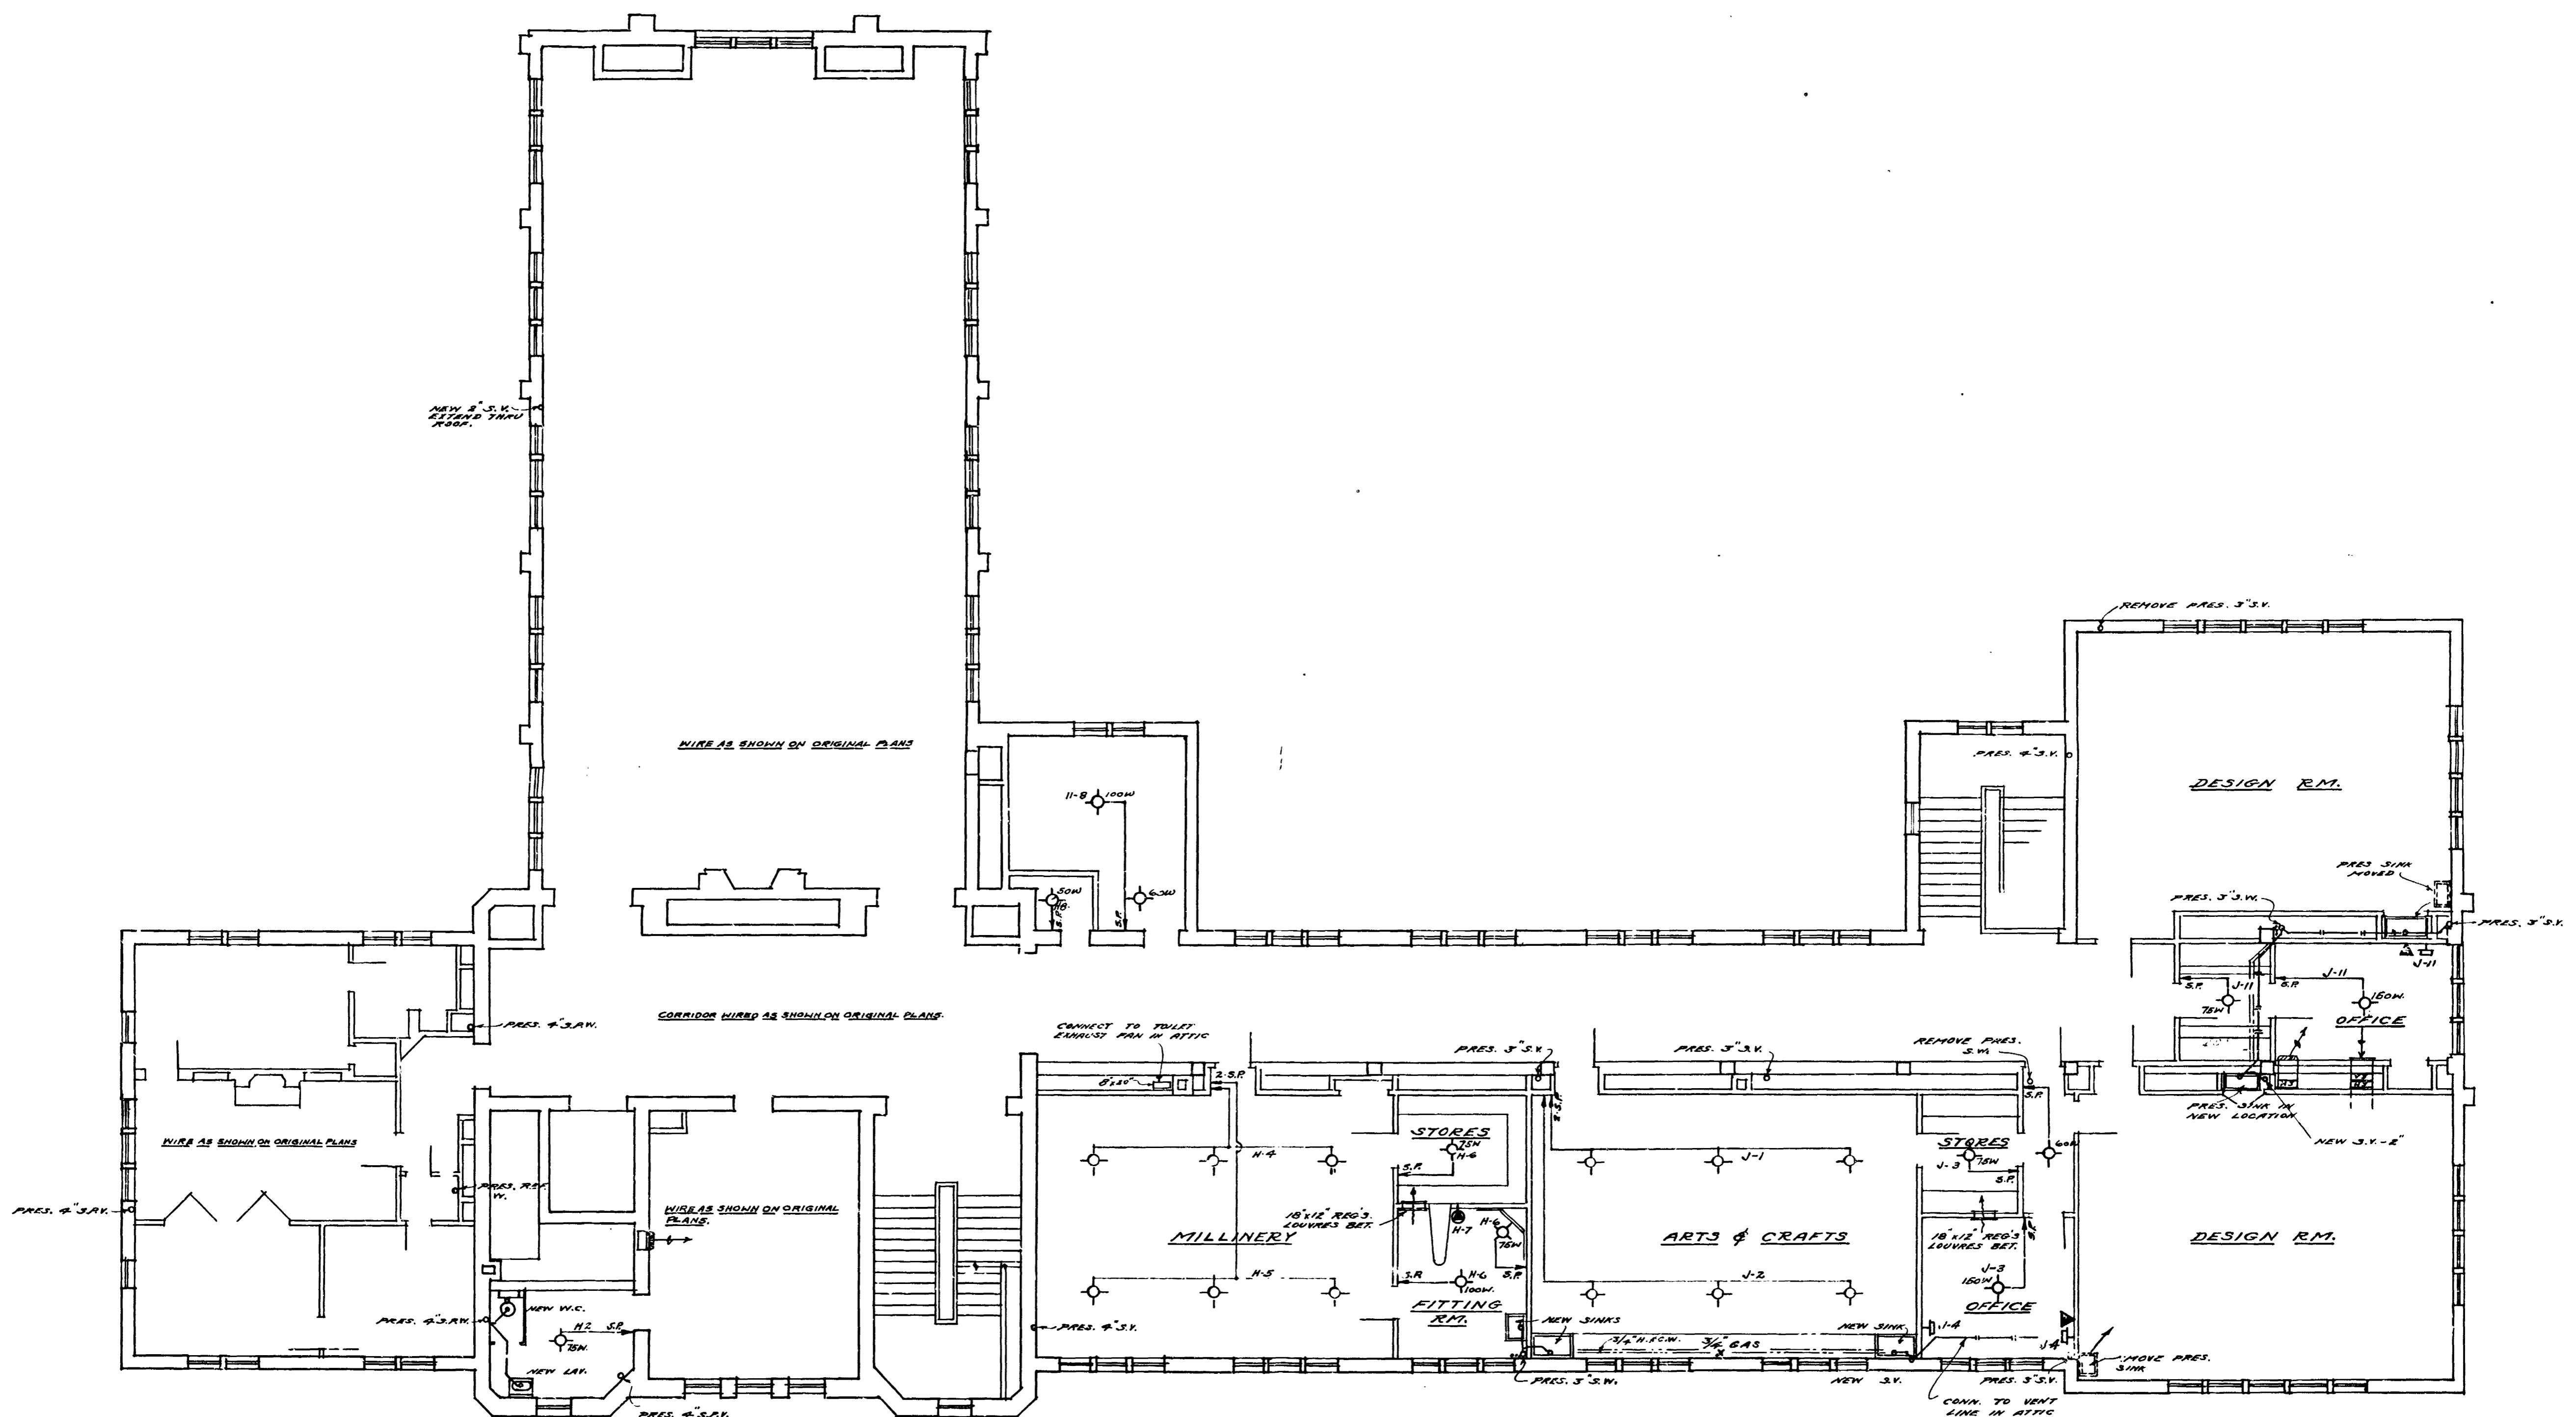

B-17-73

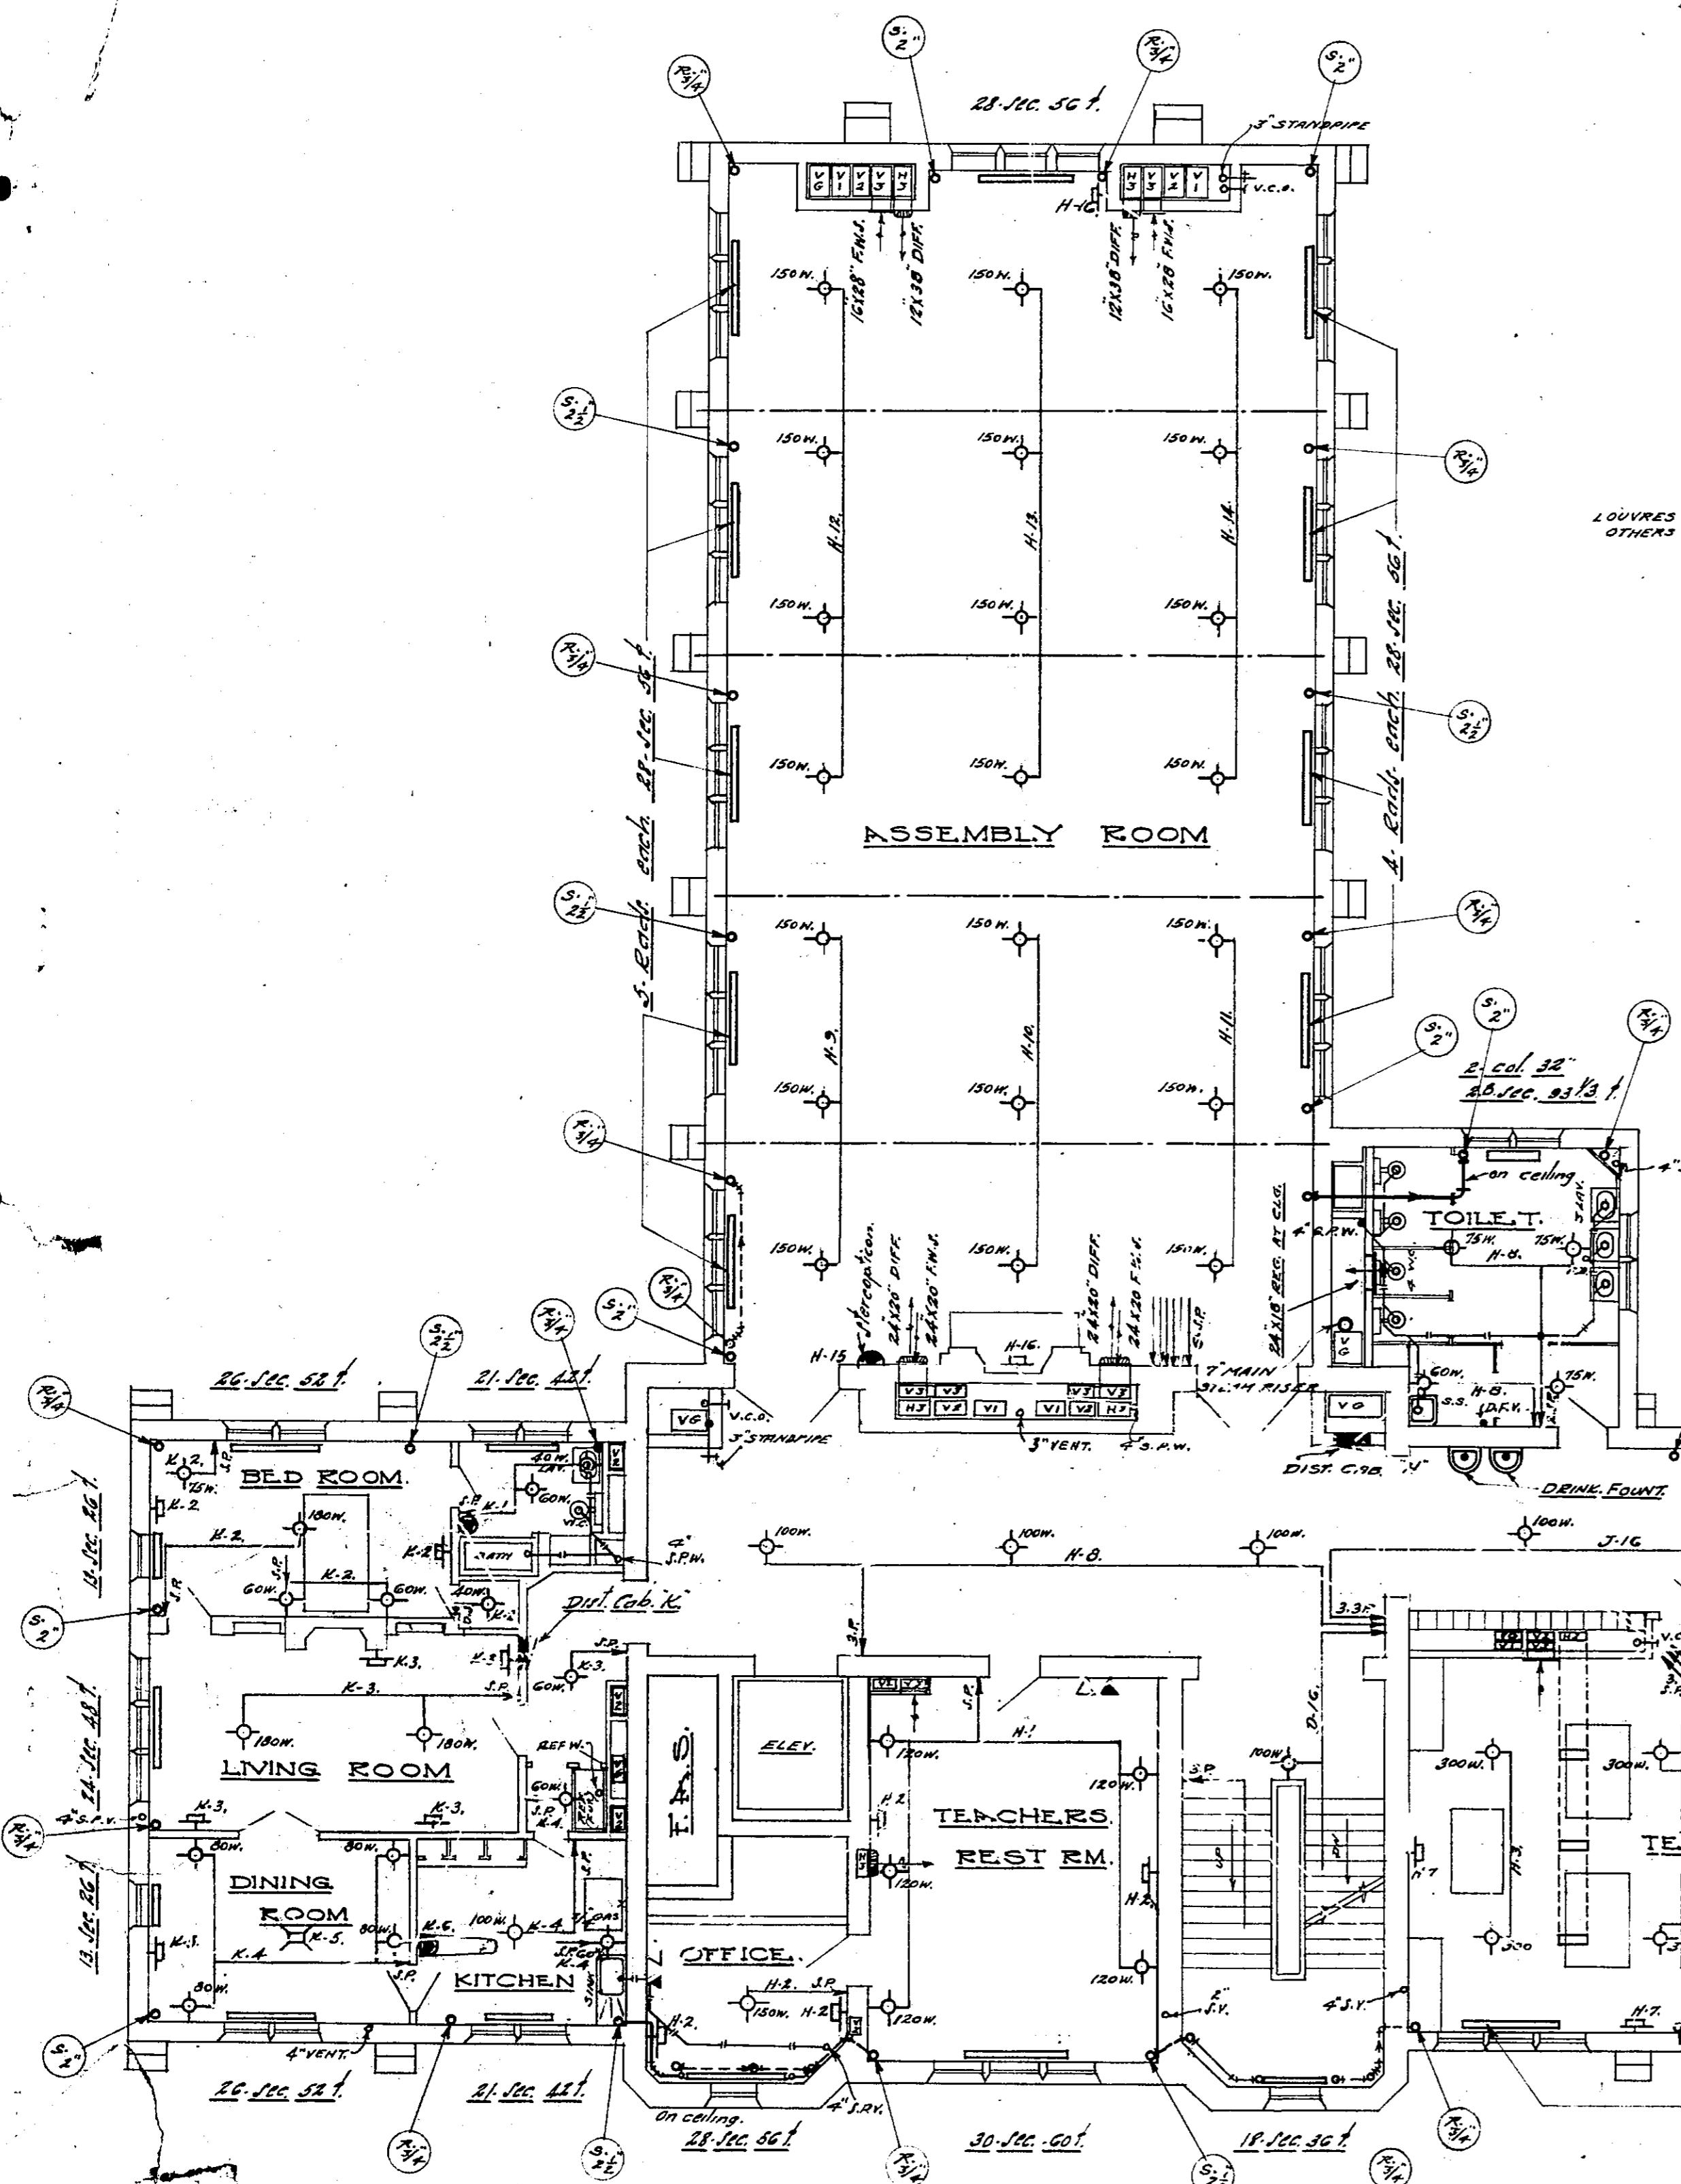


THIRD FLOOR PLAN


SCALE 1:60

Note

All radiators on this floor to be 1-col 26" unless otherwise noted

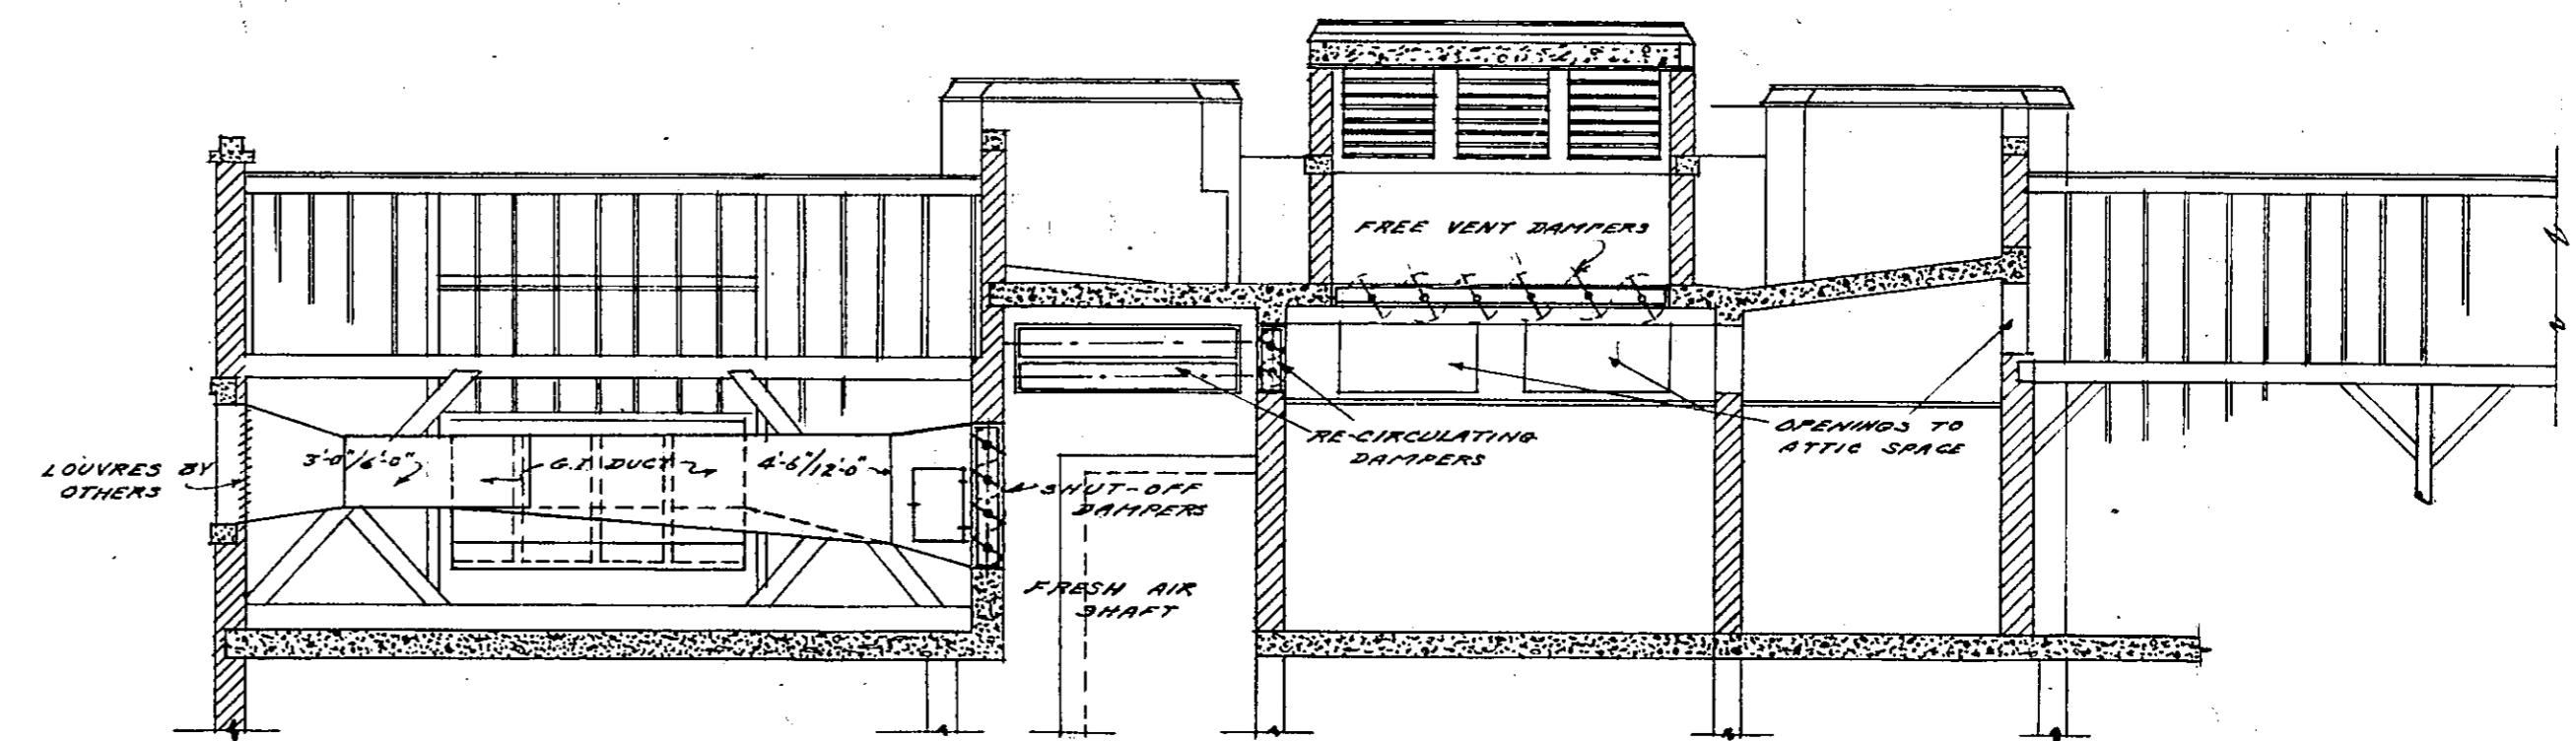

SECTION THRU TOWER
SCALE 1:60

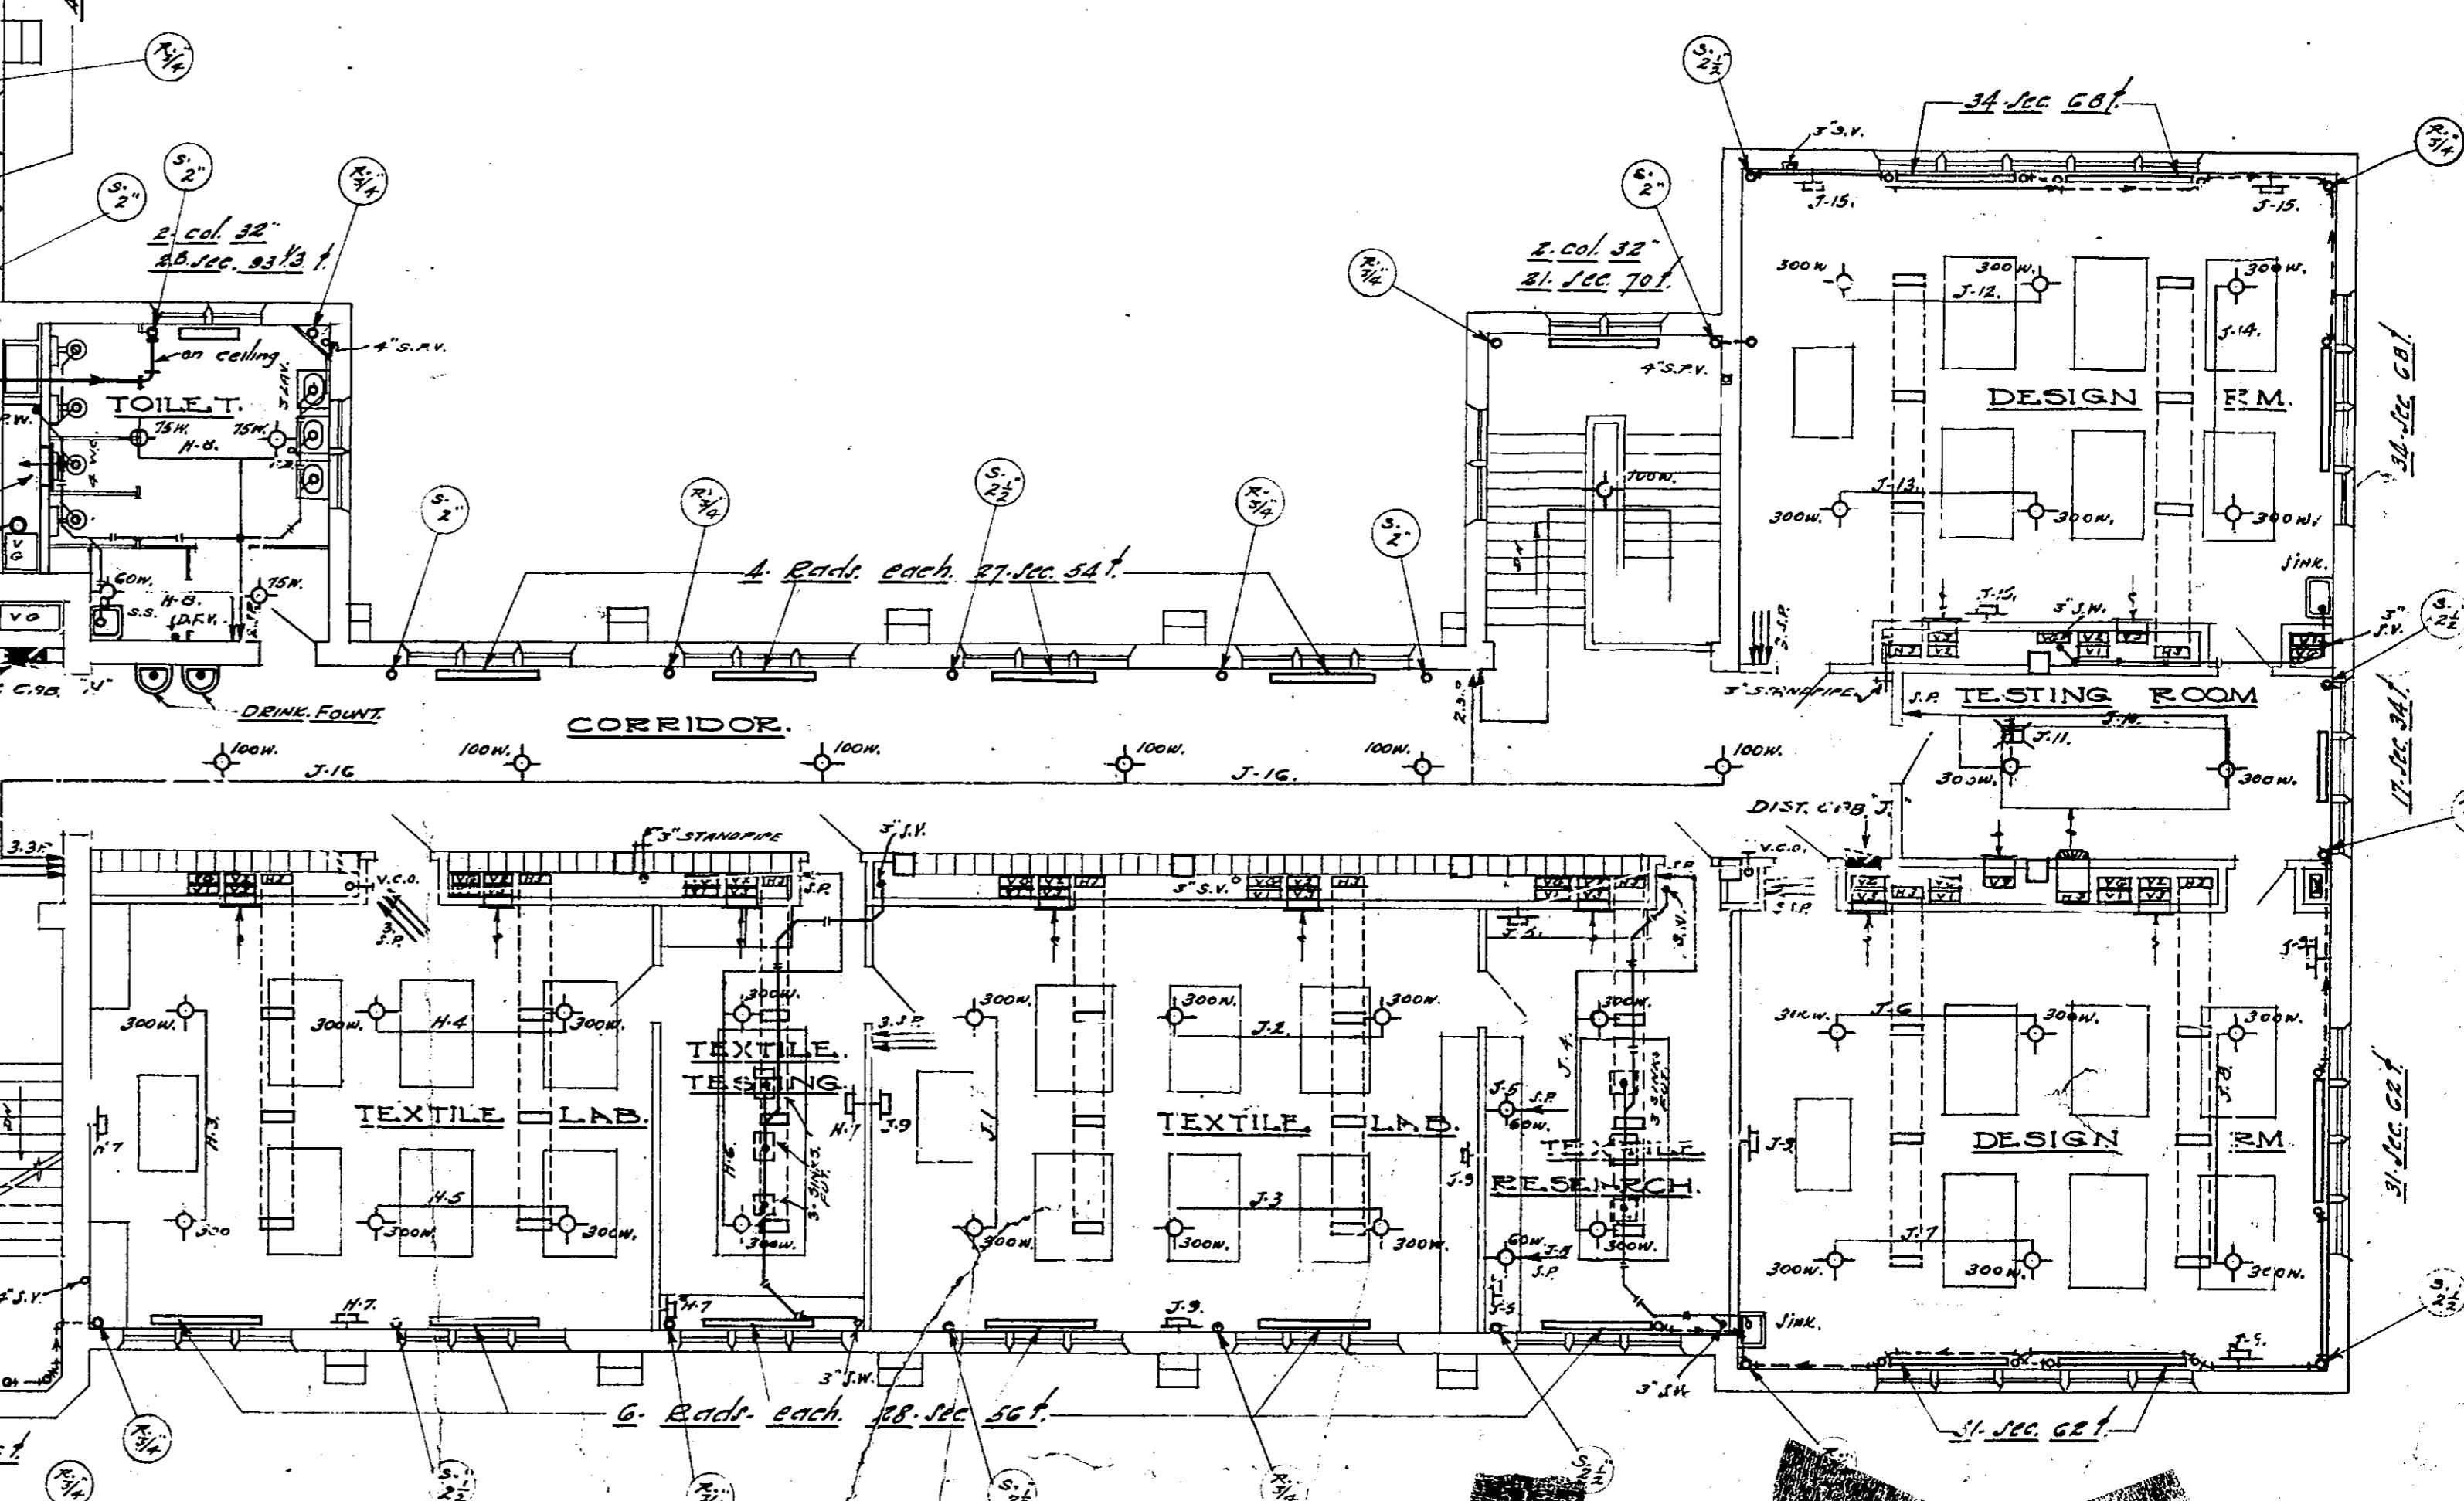

THIRD FLOOR PLAN

SCALE 1:60

EDWYN B. END.
ARCHITECT
LANSING, MICHIGAN
ECONOMIC
MICHIGAN AGRICULTURAL COLLEGE
APPROVED BY

5

623

PART 1 - GENERAL

1.1 SUMMARY

- A. Section includes administrative and procedural requirements governing allowances.
- B. Types of allowances include the following:
 - 1. Unit-cost allowances.
- C. Related Requirements:
 - 1. Section 012200 "Unit Prices" for procedures for using unit prices, including adjustment of quantity allowances when applicable.

1.2 DEFINITIONS

- A. Allowance: A quantity of work or dollar amount included in the Contract, established in lieu of additional requirements, used to defer selection of actual materials and equipment to a later date when direction will be provided to Contractor. If necessary, additional requirements will be issued by Change Order.

1.3 SELECTION AND PURCHASE

- A. At the earliest practical date after award of the Contract, advise Owner of the date when final selection, or purchase and delivery, of each product or system described by an allowance must be completed by the Owner to avoid delaying the Work.
- B. Obtain proposals for each allowance for use in making final selections. Include recommendations that are relevant to performing the Work.

1.4 ACTION SUBMITTALS

- A. Submit proposals for purchase of products or systems included in allowances in the form specified for Change Orders.

1.5 INFORMATIONAL SUBMITTALS

- A. Submit invoices or delivery slips to show actual quantities of materials delivered to the site for use in fulfillment of each allowance.
- B. Submit time sheets and other documentation to show labor time and cost for installation of allowance items that include installation as part of the allowance.

C. Coordinate and process submittals for allowance items in same manner as for other portions of the Work.

1.6 UNIT-COST ALLOWANCES

A. Allowance shall include cost to Contractor of specific products and materials ordered or selected by Owner under allowance and shall include freight, and delivery to Project site.

B. Unless otherwise indicated, Contractor's costs for receiving and handling at Project site, labor, installation, overhead and profit, and similar costs related to products and materials ordered or selected by Owner under allowance shall be included as part of the Contract Sum and not part of the allowance.

C. Unused Materials: Return unused materials purchased under an allowance to manufacturer or supplier for credit to Owner, after installation has been completed and accepted.

1. Deliver unused material to Owner's storage space as directed.

1.7 ADJUSTMENT OF ALLOWANCES

A. Allowance Adjustment: To adjust allowance amounts, prepare a Change Order proposal based on the difference between purchase amount and the allowance, multiplied by final measurement of work-in-place where applicable. If applicable, include reasonable allowances for cutting losses, tolerances, mixing wastes, normal product imperfections, required maintenance materials, and similar margins.

1. Include installation costs in purchase amount only where indicated as part of the allowance.
2. If requested, prepare explanation and documentation to substantiate distribution of overhead costs and other markups.
3. Submit substantiation of a change in scope of Work, if any, claimed in Change Orders related to unit-cost allowances.
4. Owner reserves the right to establish the quantity of work-in-place by independent quantity survey, measure, or count.

B. Submit claims for increased costs due to a change in the scope or nature of the allowance described in the Contract Documents, whether for the purchase order amount or Contractor's handling, labor, installation, overhead, and profit.

1. Do not include Contractor's or subcontractor's indirect expense in the Change Order cost amount unless it is clearly shown that the nature or extent of Work has changed from what could have been foreseen from information in the Contract Documents.
2. No change to Contractor's indirect expense is permitted for selection of higher- or lower-priced materials or systems of the same scope and nature as originally indicated.

PART 2 - PRODUCTS (Not Used)

PART 3 - EXECUTION

3.1 EXAMINATION

- A. Examine products covered by an allowance promptly on delivery for damage or defects. Return damaged or defective products to manufacturer for replacement.

3.2 PREPARATION

- A. Coordinate materials and their installation for each allowance with related materials and installations to ensure that each allowance item is completely integrated and interfaced with related work.

3.3 SCHEDULE OF ALLOWANCES

- A. Allowance No. 1: Quantity Allowance: Include 300 linear feet of brick masonry mortar joint repointing in base bid.
 - 1. Coordinate quantity allowance adjustment with unit-price requirements in Section 012200 "Unit Prices."
- B. Allowance No. 2: Quantity Allowance: Include 200 square feet of brick masonry patching and repairs on base bid.
 - 1. Coordinate quantity allowance adjustment with unit-price requirements in Section 012200 "Unit Prices."

END OF SECTION 012100

PART 1 - GENERAL

1.1 SUMMARY

- A. Section includes administrative and procedural requirements for unit prices.
- B. Related Requirements:
 - 1. Section 012100 "Allowances" for procedures for using unit prices to adjust quantity allowances.

1.2 DEFINITIONS

- A. Unit price is an amount incorporated into the Agreement, applicable during the duration of the Work as a price per unit of measurement for materials, equipment, or services, or a portion of the Work, added to or deducted from the Contract Sum by appropriate modification, if the scope of Work or estimated quantities of Work required by the Contract Documents are increased or decreased.

1.3 PROCEDURES

- A. Unit prices include all necessary material, plus cost for delivery, installation, insurance, overhead, and profit.
- B. Measurement and Payment: See individual Specification Sections for work that requires establishment of unit prices. Methods of measurement and payment for unit prices are specified in those Sections.
- C. Owner reserves the right to reject Contractor's measurement of work-in-place that involves use of established unit prices and to have this work measured, at Owner's expense, by an independent surveyor acceptable to Contractor.
- D. List of Unit Prices: A schedule of unit prices is included in Part 3. Specification Sections referenced in the Part 3 "Schedule of Unit Prices" Article contain requirements for materials described under each unit price.

PART 2 - PRODUCTS (Not Used)

PART 3 - EXECUTION

3.1 SCHEDULE OF UNIT PRICES

- A. Unit Price No. 1: Repointing of Brick Masonry Mortar Joints.

1. Description: Repointing of brick mortar joints, as required, in accordance with Section 040323 – “HISTORIC BRICK UNIT MASONRY REPOINTING.”
2. Unit of Measurement: Linear foot of crack to be repaired.
3. Quantity Allowance: Coordinate unit price with allowance adjustment requirements in Section 012100 "Allowances."

B. Unit Price No. 2: Brick Masonry Repair.

1. Description: Repair brick masonry in accordance with Section 040322 - HISTORIC BRICK UNIT MASONRY REPAIR.
2. Unit of Measurement: Square feet of area of brick wall, first wythe from exterior only.

END OF SECTION 012200

PART 1 - GENERAL

1.1 SUMMARY

- A. Section includes administrative and procedural requirements for alternates.

1.2 DEFINITIONS

- A. Alternate: An amount proposed by bidders and stated on the Bid Form for certain work defined in the bidding requirements that may be added to or deducted from the base bid amount if the Owner decides to accept a corresponding change either in the amount of construction to be completed or in the products, materials, equipment, systems, or installation methods described in the Contract Documents.
 - 1. Alternates described in this Section are part of the Work only if enumerated in the Agreement.
 - 2. The cost or credit for each alternate is the net addition to or deduction from the Contract Sum to incorporate alternates into the Work. No other adjustments are made to the Contract Sum.

1.3 PROCEDURES

- A. Coordination: Revise or adjust affected adjacent work as necessary to completely integrate work of the alternate into Project.
 - 1. Include, as part of each alternate, miscellaneous devices, accessory objects, and similar items incidental to or required for a complete installation, whether or not indicated as part of alternate.
- B. Execute accepted alternates under the same conditions as other Work of the Contract.
- C. Schedule: A Part 3 "Schedule of Alternates" Article is included at the end of this Section. Specification Sections referenced in schedule contain requirements for materials necessary to achieve the work described under each alternate.

PART 2 - PRODUCTS (Not Used)

PART 3 - EXECUTION

3.1 SCHEUDLE OF ALTERNATES

- A. Alternate No. 1, Provide pre-patinated all copper materials and products to match existing patina on copper on existing roof ridge cap.

1. Base Bid: As indicated in Specifications and on Drawings.
- B. Alternate No. 2, Provide masonry repairs and unit replacement between finish grade and roof eave line indicated on Drawings. Please refer to sheet A200 (Exterior Elevations) for the roof/ eave line designation.
 1. Base Bid: Provide masonry repairs and unit replacement from roof eave line indicated on Drawings to top of masonry at all masonry surfaces of the Building exterior. Clean all masonry surfaces of Building exterior.
- C. Alternate No. 3, Revise the following downspout and underground stormwater design as follows:
 1. Eliminate new external copper gutters connecting into new underground drainage system as indicated on architectural and civil engineering drawings.
 2. Eliminate new underground stormwater drainage system as indicated on civil engineering drawings.
 3. Existing underground drainage infrastructure shall remain as is.
 4. Connect new gutters to existing internal roof conductors with copper elbows and fitting specified. Align connections from new downspouts to existing roof conductor hole locations in walls.
 5. New exterior downspouts draining onto low-slope roof areas shall remain in the project scope.
 6. The exterior downspout at the west side of the north stair shall be replaced and connected into the existing underground system as it is indicated.

END OF SECTION 012300